


Section 16 Township 11 Range 15 W

Well No. #2 Whitson

Company Aylward Oil Co.

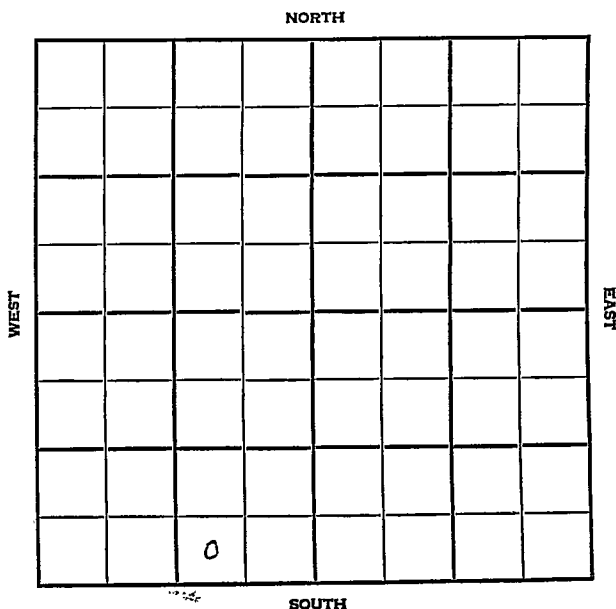

Russell

KANSAS

SEC. 16	TWP. 11	R. 15W	15W
---------	---------	--------	-----

WELL NO. #2 Whitson FARM

COMPANY Aylward Oil Co.

CONTRACTOR

Fairport


_____ Ft. from N. Line

_____ Ft. from S. Line

_____ Ft. from E. Line

_____ Ft. from W. Line

SW SE SW

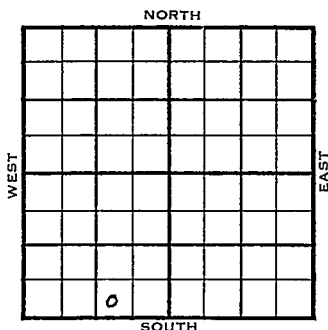

1955	ELEVATION	REPORT																								
7/27	1900'	<p>Comm 6-25-55 8 5/8" @103/75 DST 3204-15 open 1/2 hr. Rec. 15' ocm 15' wtry mud 300' gas 250/20" 5 1/2" φ3386 GO 20/3358-64 250A S/11 bo 14 hr. PB. 3353 23/3345-53 500 A S/4 boph 2 hr. PB 3340 18/3334-40 1000 A S/5 boph comp 50 bopd. Anh. 965</p> <table border="0"> <tr> <td>Tp.</td> <td></td> <td>2709</td> <td>809</td> </tr> <tr> <td>H.</td> <td>2963</td> <td>2960</td> <td>1060</td> </tr> <tr> <td>Tr.</td> <td>2981</td> <td>2978</td> <td>1078</td> </tr> <tr> <td>L.</td> <td>3011</td> <td>3008</td> <td>1108</td> </tr> <tr> <td>A.</td> <td></td> <td>3333</td> <td>1433</td> </tr> <tr> <td>TD.</td> <td>3386</td> <td></td> <td></td> </tr> </table>	Tp.		2709	809	H.	2963	2960	1060	Tr.	2981	2978	1078	L.	3011	3008	1108	A.		3333	1433	TD.	3386		
Tp.		2709	809																							
H.	2963	2960	1060																							
Tr.	2981	2978	1078																							
L.	3011	3008	1108																							
A.		3333	1433																							
TD.	3386																									

FIRST REPORT

COMPLETED

County Russell Elev. 1900
 Sec. 16 Twp. 11 Rge. 15W
 Company Aylward Oil Co.
 FarmName Whitson No. 2

TOPS	DEPTH	LOG	DATUM	Loc. in Sec.
Anh.	965			SW SE SW
Tp.		2709	809	
H.	2963	2960	1060	
Tr.	2981	2978	1078	
Dg.				
Bl.				
L.	3011	3008	1108	Geol.
K.C.				Contr.
B.K.C.				
Ce.				
C.				
M.				
M.				Pool
K.				Fairport
Mz.				
Me.				
V.				
S.				
S.				
A.		3333	1433	FIRST REPORT COMPLETE
R.				
PE.				
G.				
T.D.	3386			0

Date Comm. 6-25-55 **JUL 27 1955**
8 5/8" @ 103/75 DST 3204-15 open 1/2 hr.
 Rec. 15' ocm 15' wtry mud 300' gas
250/20" 5 1/2" @ 3386 CO 20/ 3358-64
250 A S/ 11 bo 14 hr. PB 3353
23/ 3345-53 500 A S/ 4 boph 2 hr.
PB 3340 18/ 3334-40 1000 A S/ 5 boph
 Comp. 50 bopd

7

Co.
Lse.
No.
Sec.
T.
R.