


Section 16 Township 11 Range 15W

Well No. #3 Whitson

Company Summitt Oil

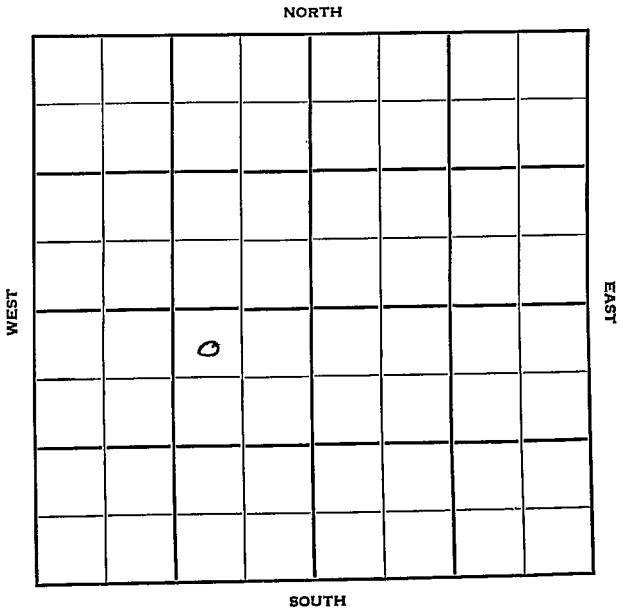

Russell

KANSAS 15W
R.

Sec. 16 Twp. 11

Well No. #3 Whitson Farm

Summitt Oil Company

Contractor


330 Ft. from N. Line

Ft. from S. Line

990 Ft. from E. Line

Ft. from W. Line

SW $\frac{1}{4}$ NW NE SW

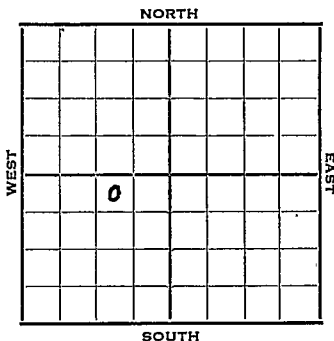

1952 Elev. 1931' REPORT

10/29 Spud 10-25-52
8" @ 156'
Anhy 1007'
Drlg. 1600'

11/5 Topeka 2742 Heeb. 2994
Lans. 3041
Making trip @ 3175'

11/12 Arb. 3365 RTD 3374
5" @ 3374' CO POP

11/20 NR

11/27 NR

12/3 Spud 10-25-52
OilWell
TD 3379
8" @ 156
Anhy 1007', Top. 2742', Heeb
2994', Lans 3041', Arb 3365
5" @ 3374,
TD 3374
DD 3379
FU 1600' oil 3 hrs.,
Comp. 75 bopd

COMPLETED

