


DX 78-1

Russell

KANSAS


Section 16 Township 11 Range 15 W
Well No. #6 Whitson
Company Okmar Oil

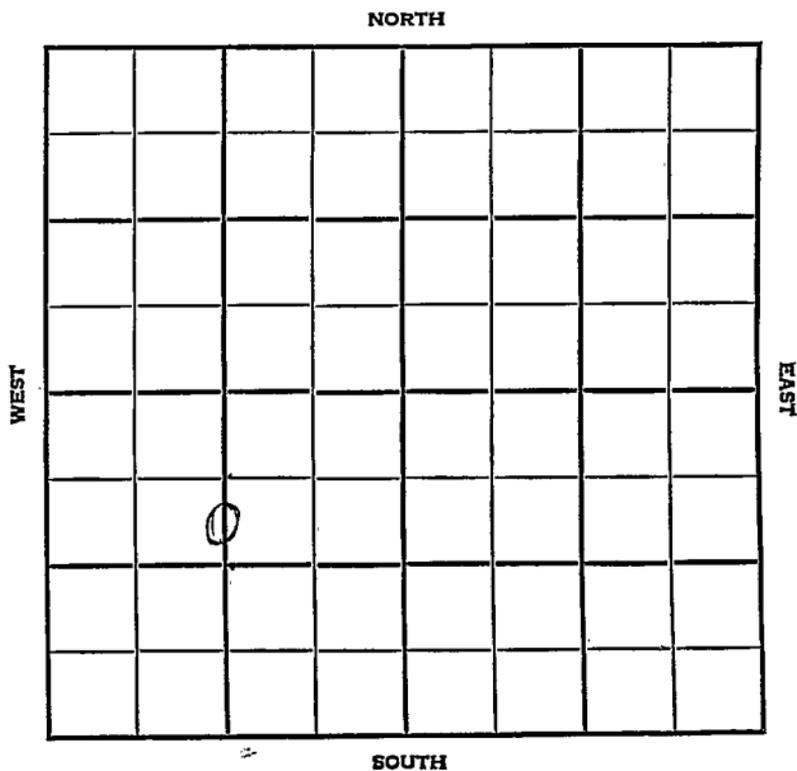

County Russell Elev. _____
 Sec. 16 Twp. 11 Rge. 15
 Company Okmar Oil
 Farm Name Whitson No. 6

TOPS	DEPTH	LOG	DATUM	Loc. in Sec.
Anh.				C S/2 N/2 SW
Tr.				
H.				
Tr.				
Dg.				
Bl.				
L.				
K.C.			Geol. _____	
B.K.C.			Contr. _____	
Ce.				
C.				
M.				
M.			Pool	
K.			Fairport	
Mz.				
Mo.				
V.				
S.				
S.				
A.				
R.				
Pe.				
G.				
T.D.				FIRST REPORT

Date Comm. 11-25-56
8 5/8" 220/150, Drlg. 1410

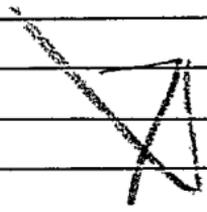

Co.
 Lse.
 No.
 Sec.
 T.
 R.

County Russell Elev. 1901
 Sec. 16 Twp. 11 Rge. 15
 Company Okmar Oil
 Farm Name Whitson No. 6

TOPS	DEPTH	LOG	DATUM	Loc. in Sec.
Anh.	975			C S/2 N/2 SW
Top.	2714?			
H.	2965			
Tr.	2989			
Dg.				
Bl.				
L.	3013			Geol.
K.C.				Contr.
B.K.C.				
Ce.				
C.				
M.				Pool
M.				Fairport
K.				
Mz.				
Me.				
V.				
S.				
S.				
A.	3348			COMPLETE
R.				
PE.				
G.				
TD.	3351			JAN 2 '57

Date Comm. 11-25-56
8 5/8" 220/150, Drlg. 1410 DEC 5 '56
DST 2923-50 lhu 20' HO CM
+70' 50 CM NO BHP record
DST 2972-3005 lhu 10' 50 CM
BHP 30/30" DST 2995-3030
30" 60' HO & 6 CM + 150' ME 6 CM
+20' WM BHP 325/30 DST 302
-50 lhu 15' HO CM + 65' 50 CM BHP
300/20" DST 3094-3108. 30"

320' SW BHP 255/50 Ø 3204

DEC 12 '56 DST 3204-14 1hr 12'

08' LCM BHP 110/30 DST

3238-55 1hr 5' Md BHP 0/30

5 1/2 3350 / 200 WOCT DEC 19 '56

DEC 26 '56 CO DD 3356 N.S. M

no inc DD 3365 / 2 & 3 Boph

no/w 5 hrs Pop JAN 2 '57 P. 25

Bopd no/w tr