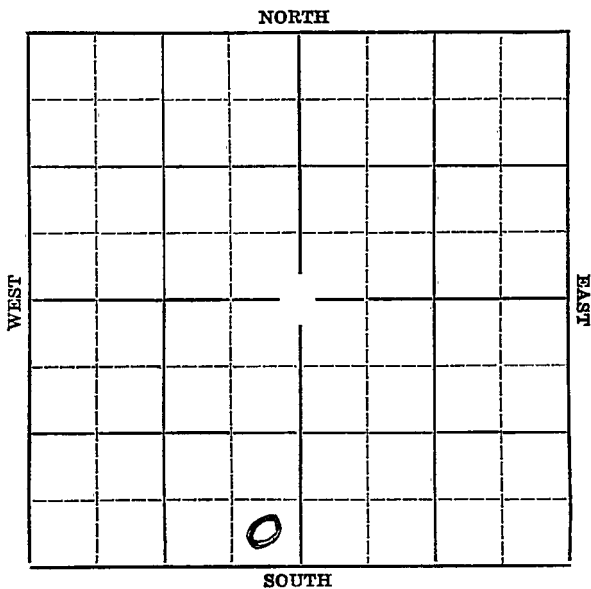


Section 16 Township 11 Range 17WWell Number #1 BemisCompany National Ref.

Map No. 71 Sec. 16 Twp. 11 R. 12WWell No. 1 BemisNational Ref. Company

Contractor

SECTION PLAT

 Ft. from N. Line330 Ft. from S. Line230 Ft. from E. Line Ft. from W. Line

FIRST REPORT

Location ✓Rig up

Drilling and Remarks:

RECORD

Cased in., ft.Sand Gas Oil Total Depth

PRODUCTION

1st 24 hrs. Nat. 1st 24 hrs. after shot Gas Cu. Ft.Dry Hole Abandoned

Date

MAY 20 1936 19

S. J. LEWIS

Scout

KANSAS

Map No. 71 Sec. 16 Twp. 11 R. 17W

Well No. 1 Bemis

National Ref. Company

Contractor

SECTION PLAT

_____ Ft. from N. Line

330 Ft. from S. Line

330 Ft. from E. Line

_____ Ft. from W. Line

ABANDONED

Location _____

Rig up _____

Drilling and Remarks:

Oil 3347
P.B 3365
1000 acid
2 1/2 x 8 ft watered
a day
J. J. H.

RECORD

Cased _____ in., _____ ft.

Sand _____

Gas _____

Oil _____

Total Depth 3433

PRODUCTION

1st 24 hrs. Nat. _____

1st 24 hrs. after shot _____

Gas _____ Cu. Ft.

Dry Hole _____

Abandoned _____

Date

AUG 19 1936 19 S. J. LEWIS Scout