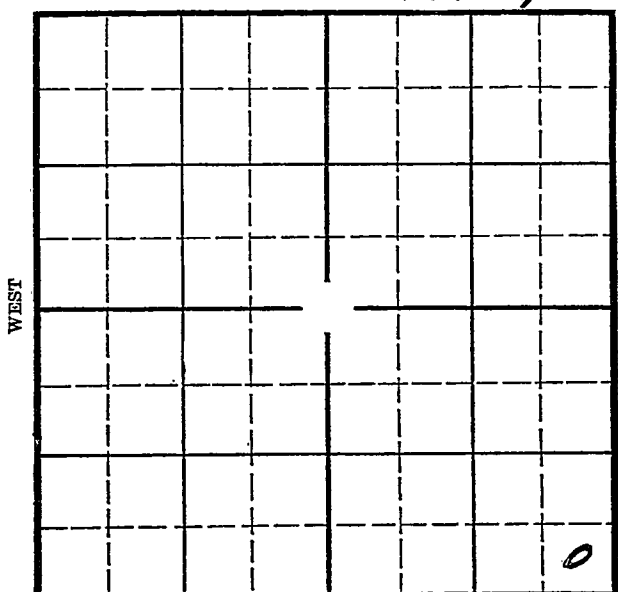


Map No. KANSAS Sec. 16 Twp. 11 R. 17WWell No. 136 Farm EllisLewis K. Smith CompanyNORTH MARGAY

SOUTH

Location _____

Drilling Remarks _____

Rig Up _____

Drilling Remarks _____

RECORD

Cased _____ in. _____ ft.

Sand _____

Gas _____

Oil _____

Total Depth _____

PRODUCTION

1st 24 hrs. Nat. _____

1st 24 hrs. after shot _____

Gas _____ cu. ft. _____

Dry Hole _____

Abandoned _____

Ellis

Map No. KANSAS Sec. 16 Twp. 11 R. 17W

Well No. 1- Bernis Farm
Lewis Roach & Co. Company


MARGAY

 Ft. from N. Line

330 Ft. from S. Line

330 Ft. from E. Line

 Ft. from W. Line

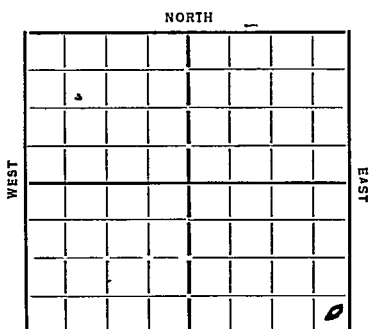

Elev. 1900

REPORT **O. W. D. D**

Date	Notes
6/26	Rog
7/3	
7/11	Rig
7/18	Rgn
8/8	Alg 770
8/15	
8/22	Alg 1700 HFW 790
8/29	" 2292 8" 2175
9/6	" 2595
9/3	3040 a R 6"
10/10	
10/24	Topeka 2830
	TD 3040
	2000 acid
	514 Hbl.

COMPLETED

O. W. D. D

7/1/36- OLD TOTAL DEPTH 3040'
RIGGING Up.

7/9 Drlg. 3345'.
7/16 Sil. 33412' - FT 33412'. TD. RUST.

OVER

7/23-Pay 3412-15'. T.D. 3439'. Hole rf
full of oil in 36 hours.

7/29/36-Sil. 3412'. TD 3439'.
Potential 890'.
 $\frac{1}{2}\%$ water.

COMPLETED

Map No. 77 Sec. 16 Twp. 11 R. 17NWell No. 1 BemisLewis Rock & Oil Company

Contractor

SECTION PLAT

			0

Ft. from N. Line

320 Ft. from S. Line320 Ft. from E. Line

Ft. from W. Line

REPORTS

Location

Rig up

Drilling and Remarks:

ROG

RECORD

Cased.....in., ...ft.

Sand.....

Gas.....

Oil.....

Total Depth.....

PRODUCTION

1st 24 hrs. Nat.....

1st 24 hrs. after shot.....

Gas.....Cu. Ft.

Dry Hole.....

Abandoned.....

Date

67/26/35 192

ORVAL MANNSCHRECK

Scout

no more

[Handwritten signature]

[Handwritten signature]

Returned	<i>[Handwritten initials]</i>
Cards	<i>[Handwritten initials]</i>
Tracing	<i>[Handwritten initials]</i>
France Map	X
Seaborough Map	X
Moody Map	X
Seaborough Flat Book	
Moody Flat Book	

KANSAS

Map No. 71 Sec. 16 Twp. 11 R. 17^W

Well No. 1-Bemis

Lewis Roark et al Company

Contractor

COMPLETED

SECTION PLAT

.....Ft. from N. Line

330 Ft. from S. Line

330 Ft. from E. Line

.....Ft. from W. Line

Location.....

Rig up.....

Drilling and Remarks:

2000 acid

514
ffb

RECORD

Cased.....in.,.....ft.

Sand Topoka 2830

Gas.....

Oil.....

Total Depth 3040

PRODUCTION

1st 24 hrs. Nat.....

1st 24 hrs. after shot.....

Gas.....Cu. Ft.

Dry Hole.....

Abandoned.....

Date

10-24-35 192

ORVAL MANN SCHRECK

Scout

Returned

Cards

Tracing

France M P

Scarborough Map

Moody Map

Scarborough Flat Book

Moody Flat Book

Map No. 71 Sec. 16 Twp. 11 R. 17WWell No. 1 BemisMargay Company

Contractor

CORRECTION
~~EACH NAME~~
~~COMPANY~~

SECTION PLAT

Ft. from N. Line

330 Ft. from S. Line330 Ft. from E. Line

Ft. from W. Line

FIRST REPORT

OW 117

Location _____

Rig up _____

Drilling and Remarks:

Old TD 3040Rigging up

RECORD

Cased _____ in., _____ ft.

Sand _____

Gas _____

Oil _____

Total Depth _____

PRODUCTION

1st 24 hrs. Nat. _____

1st 24 hrs. after shot _____

Gas _____ Cu. Ft.

Dry Hole _____

Abandoned _____

Date

JUL 1936

19

S. J. LEWIS

Scout

Returned

Cards

Tracing

France Map

Scarborough Map

Moody Map

Scarborough Plat Book

Moody Plat Book

KANSAS

Form 26-1M Bks.—2-29

Map No. 71 Sec. 16 Twp. 11 R. 13Well No. 1 BenisMargay CompanyMargay Contractor

SECTION PLAT

 Ft. from N. Line330 Ft. from S. Line330 Ft. from E. Line Ft. from W. Line

COMPLETED

Location Rig up

Drilling and Remarks:

Sic 3412P 88901/2% water

RECORD

Cased in., ft.Sand Gas Oil Total Depth 3439

PRODUCTION

1st 24 hrs. Nat. 1st 24 hrs. after shot Gas Cu. Ft.Dry Hole Abandoned

Date

JUL 29 1936S. J. LEWIS Scout

Returned

Cards

Tracing

France Map

Scarborough Map

Moody Map

Scarborough Plat Book

Moody Plat Book