


Section 16 Township 11 Range 17-W

Well Number #5-Bemis "A"

Company Margay

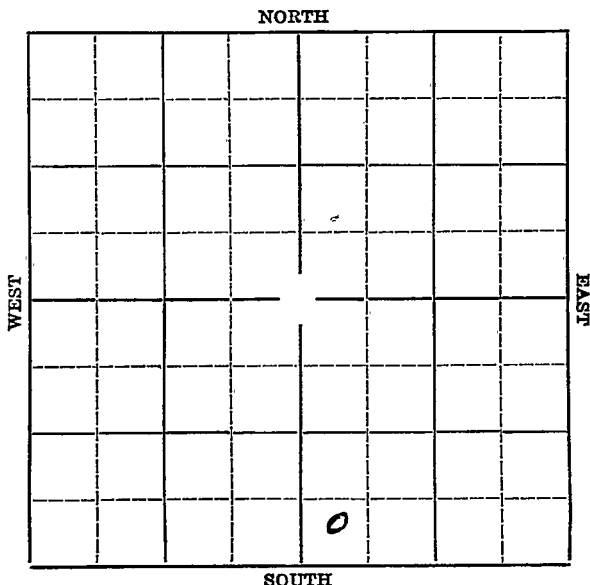


Well No. #5 Bemis "A" Farm

Margay Company

330 Ft. from S. Line

330' Ft. from W. Line

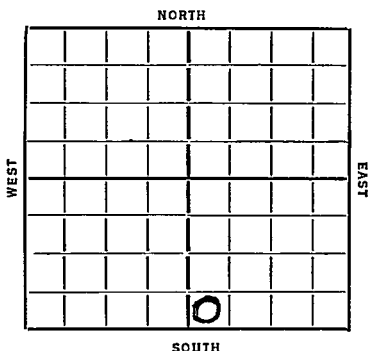

REPORT

7/9	3380'. Rigging up standard tools.
-----	-----------------------------------

Pay 3357-62'.

T.D. 3362'.

664 bbls natural potential.

COMPLETED

KANSAS

Map No. 71 Sec. 16 Twp. 11 R. 17WWell No. 5 Benish "A"Margay CompanyJJ Contractor

SECTION PLAT

 Ft. from N. Line330 Ft. from S. Line Ft. from E. Line330 Ft. from W. Line

FIRST REPORT

Location Rig up

Drilling and Remarks:

Building rig

RECORD

Cased in., ft.Sand Gas Oil Total Depth

PRODUCTION

1st 24 hrs. Nat. 1st 24 hrs. after shot Gas Cu. Ft.Dry Hole Abandoned

Date

JUN 10 1936

19

Scout

Map No. 71 Sec. 16 Twp. 11 R. 17WWell No. 5 Bemis "A"Margay Oil CompanyS J Contractor

SECTION PLAT

 Ft. from N. Line330 Ft. from S. Line Ft. from E. Line330 Ft. from W. Line

COMPLETED

RECORD

Location Cased in., ft.Sand Gas Oil Total Depth 336.2

PRODUCTION

1st 24 hrs. Nat. 1st 24 hrs. after shot Gas Cu. Ft.Dry Hole Abandoned Rig up

Drilling and Remarks:

Oil 3341Pay 3357-62Pay 664 Nat

Date

JUL 15 1936 19

S. J. LEWIS

Scout