

# KANSAS


Form 51-5M-4-36-Palace

Ellis

Section 16 Township 11 Range 17-W

Well Number #4 Bemis "A"

Company Margay

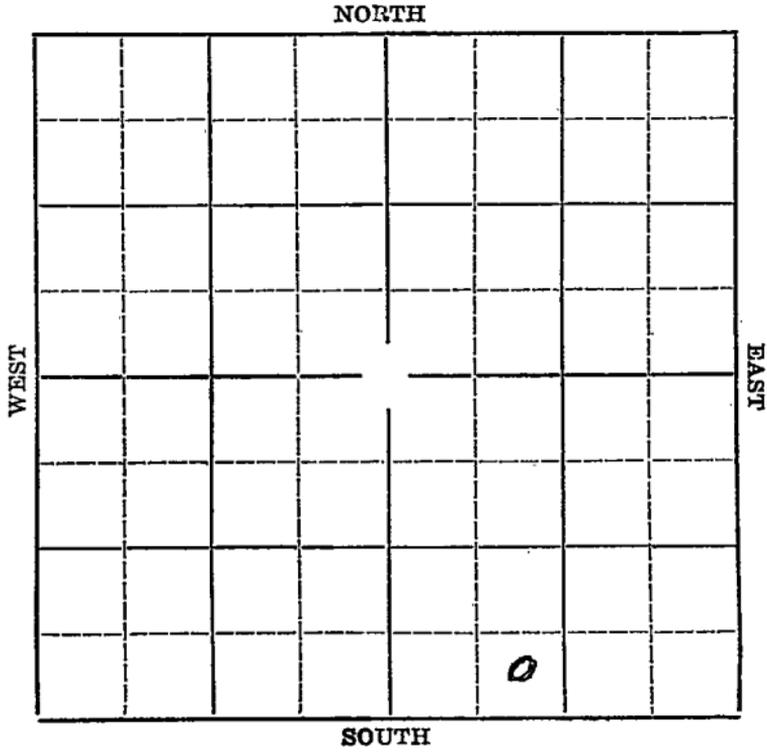

Map No. KANSAS Sec. 16 Twp. 11 R. 17W

Well No. #4 Bemmis "A" Farm

Margay Company


         Ft. from N. Line

330' Ft. from S. Line

         Ft. from E. Line

990' Ft. from W. Line

Elev. 1813

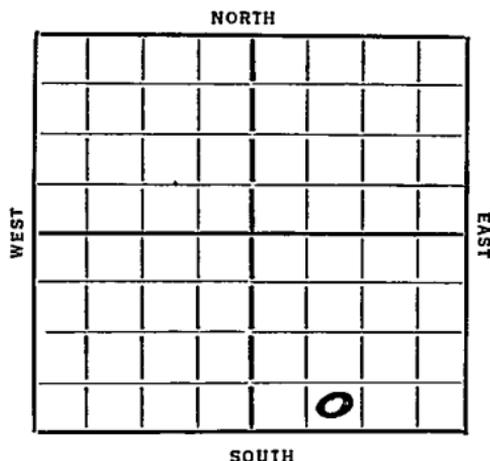

Date  
1936

REPORT

- 7/8 Spud.
- 7/16 10" @ 1040'. Waiting on cement.
- 7/23 Drlg. 2400'.
- 7/30 Drlg. 3150'.
- 8/6 Siliceous 3332'. 7" @ 3332'. Rust.
- 8/12/36-Simpson 3326'.  
  - Sil. 3332'.
  - T.D. 3332'.
  - 1369 bbls of 35.1 gravity oil.

COMPLETED

Map No. 71 Sec. 16 Twp. 11 R. 17W

Well No. 4 Bemis A.

Alway Company  
Alway Contractor

**SECTION PLAT**


\_\_\_\_\_ Ft. from N. Line

930 Ft. from S. Line

\_\_\_\_\_ Ft. from E. Line

990 Ft. from W. Line

**FIRST REPORT**

Location \_\_\_\_\_

Rig up \_\_\_\_\_

Drilling and Remarks:

Spud.

**RECORD**

Cased \_\_\_\_\_ in., \_\_\_\_\_ ft.

Sand \_\_\_\_\_

Gas \_\_\_\_\_

Oil \_\_\_\_\_

Total Depth \_\_\_\_\_

**PRODUCTION**

1st 24 hrs. Nat. \_\_\_\_\_

1st 24 hrs. after shot \_\_\_\_\_

Gas \_\_\_\_\_ Cu. Ft.

Dry Hole \_\_\_\_\_

Abandoned \_\_\_\_\_

Date

JUL 8 1936 19

S. J. LEWIS Scout

Map No. 71 Sec. 16 Twp. 11 R. 17W

Well No. 4 Bemis Co

Margay Company  
Contractor

SECTION PLAT

			o

\_\_\_\_\_ Ft. from N. Line

330 Ft. from S. Line

\_\_\_\_\_ Ft. from E. Line

990 Ft. from W. Line

COMPLETED

Location \_\_\_\_\_

Rig up \_\_\_\_\_

Drilling and Remarks:

Simpson 3326

Sci 3332

1369 88 lb.

35' Gr.

RECORD

Cased \_\_\_\_\_ in., \_\_\_\_\_ ft.

Sand \_\_\_\_\_

Gas \_\_\_\_\_

Oil \_\_\_\_\_

Total Depth 3332

PRODUCTION

1st 24 hrs. Nat. \_\_\_\_\_

1st 24 hrs. after shot \_\_\_\_\_

Gas \_\_\_\_\_ Cu. Ft.

Dry Hole \_\_\_\_\_

Abandoned \_\_\_\_\_

Date

AUG 12 1936 19

S. J. LEWIS

Scout