


Trego

Section 16 Township 11 Range 21-W

Well No. 1 Lynd

Company Manning & Martin

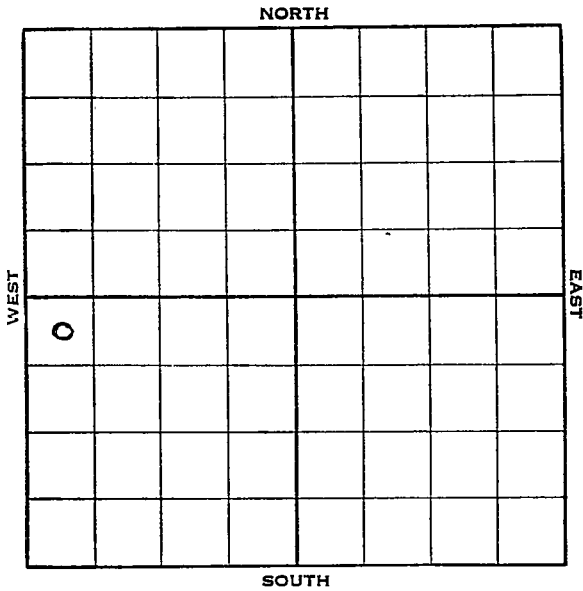

Sec. 16 Twp. 11 R. 21-W


Well No. #1 Lynd Farm  
Manning & Martin Company

330 Ft. from N. Line

\_\_\_\_\_ Ft. from S. Line

\_\_\_\_\_ Ft. from E. Line

330 Ft. from W. Line

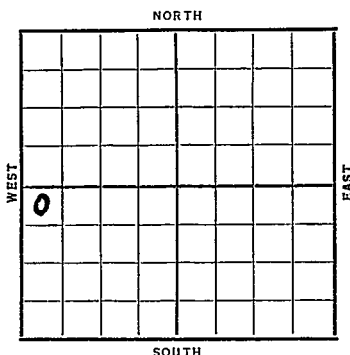

Elev. 2206

Date	REPORT
1938	
2/9	R U R
2/18	15" @ 20'. Drlg. 600'.
2/26	Anhy 1673'. Rung. 10".
3/4	" " " "
3/11	10" @ 1237'. Anhy 1673'.
	Fort Riley 2425'. Drlg. 2891'.
3/17	Top Lansing 3507 (Willson)
3/18	Topeka 3240'. Lans. 3507'.
	Drlg. 3535'. No shows rept.
3/19	Base Kansas City 3755
	Dlg. 3815 No show. (Tel)
3/25	Base K. C. 3755'.
	Cherty Cong. 3826'.
	Arb. 3949'. Coring 3967'.
	No shows.
3/30	Arb. 3949'.
	T.D; 4057' S.W.
ABANDONED	

Trego

Map No. 70 Sec. 16 Twp. 11 R. 21W

Well No. 1 Lynd

Manning & Martin Company

Contractor

**FIRST REPORT**

**SECTION PLAT**

NW SW

330 Ft. from N. Line

\_\_\_\_\_ Ft. from S. Line

\_\_\_\_\_ Ft. from E. Line

330 Ft. from W. Line

0			

Location \_\_\_\_\_

Rig up \_\_\_\_\_

Drilling and Remarks:

**RUR**

**RECORD**

Cased \_\_\_\_\_ in., \_\_\_\_\_ ft.

Sand \_\_\_\_\_

Gas \_\_\_\_\_

Oil \_\_\_\_\_

Total Depth \_\_\_\_\_

**PRODUCTION**

1st 24 hrs. Nat. \_\_\_\_\_

1st 24 hrs. after shot: \_\_\_\_\_

Gas \_\_\_\_\_ Cu. Ft.

Dry Hole \_\_\_\_\_

Abandoned \_\_\_\_\_

Date

FEB 9 1938 19

H. D. Hatfield Scout

Map No. 70 Sec. 16 Twp. 11 R. 21W

Well No. 1 Lynd

Manning & Martin Company

Contractor

ABANDONED

NW SW

330 Ft. from N. Line

\_\_\_\_\_ Ft. from S. Line

\_\_\_\_\_ Ft. from E. Line

330 Ft. from W. Line

SECTION PLAT

0			

Location \_\_\_\_\_

Rig up \_\_\_\_\_

Drilling and Remarks:

*D & A*

RECORD

Cased \_\_\_\_\_ in., \_\_\_\_\_ ft.

Sand Arb 3949

Gas \_\_\_\_\_

Oil \_\_\_\_\_

Total Depth 4057 s.w

PRODUCTION

1st 24 hrs. Nat. \_\_\_\_\_

1st 24 hrs. after shot \_\_\_\_\_

Gas \_\_\_\_\_ Cu. Ft.

Dry Hole \_\_\_\_\_

Abandoned \_\_\_\_\_

Date

MAR 30 1938

19

H. D. Hatfield Scout