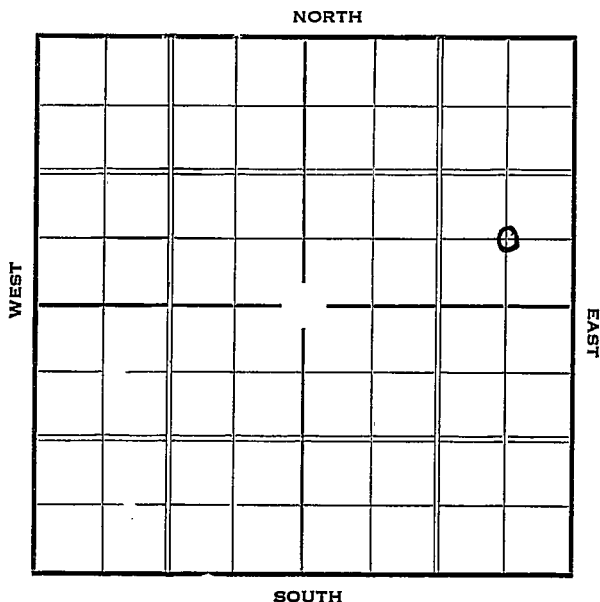


Orego


KANSAS

Section 16 Township 11 Range 23-WWell Number 1 GallowayCompany Witchorn O & S

Well No. 1 Galloway Farm
Watchorn O&G Company

Ft. from W. Line

Elev. 2294

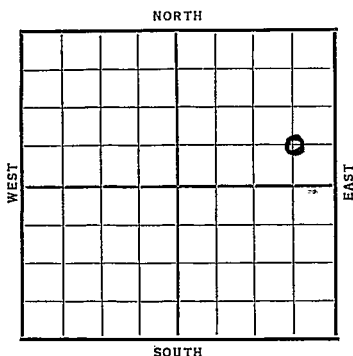[illegible]

KANSAS

Map No. 69 Sec. 16 Twp. 11 R. 23WWell No. 1 GallowayWatkins Oil & Gas Company

Contractor

SECTION PLAT

			0

_____ Ft. from N. Line

660 Ft. from S. Line660 Ft. from E. Line

_____ Ft. from W. Line

FIRST REPORT

RECORD

Location ✓

Cased _____ in., _____ ft.

Rig up _____

Sand _____

Drilling and Remarks:

Gas _____

Oil _____

Total Depth _____

PRODUCTION

1st 24 hrs. Nat. _____

1st 24 hrs. after shot _____

Gas _____ Cu. Ft.

Dry Hole _____

Abandoned _____

Date

Jan 6 1937

19

S. J. LEWIS Scout

KANSAS

Map No. 69 Sec. 16 Twp. 11 R. 23W.

Well No. 1 Galloway

Watchorn O & G Company

Contractor

SECTION PLAT

			0

_____ Ft. from N. Line

660 Ft. from S. Line

660 Ft. from E. Line

_____ Ft. from W. Line

ABANDONED

Location _____

Rig up _____

Drilling and Remarks:

Sil 4075

Water

RECORD

Cased _____ in., _____ ft.

Sand _____

Gas _____

Oil _____

Total Depth 4125

PRODUCTION

1st 24 hrs. Nat. _____

1st 24 hrs. after shot _____

Gas _____ Cu. Ft.

Dry Hole ☒

Abandoned ☒

Date

MAR 10 1937

S. J. LEWIS

Scout