


KANSAS

Trego county

Section 16 Township 11 Range 24-W

Well No. #1, Garrett

Company Madza & B & R. Drilling

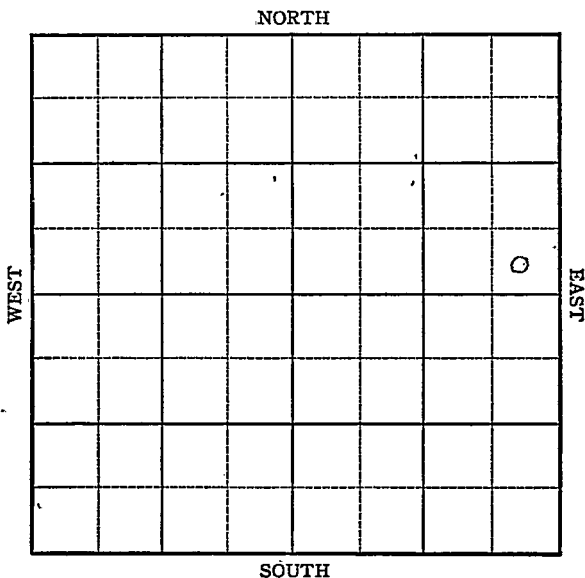

KANSAS

Trego County

Sec. 16 Twp. 11 R. 24W

Well No. #1 Garrett Farm

Madza & B & R Drlg. Company

Wildcat


Ft. from N. Line

330 Ft. from S. Line

330 Ft. from E. Line

Ft. from W. Line

SE NE

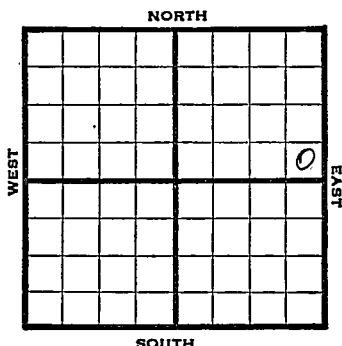

1946

Elev. 2434' REPORT

8/28 8" @ 210
Drlg. 1559'

9/5 Topeka 3538'
Lans 3788'
Drlg 4115'

9/11 Miss 4339'
Viola 4485'
Arb 4543'
TD 4573'

4543
3788

755


4543
2434

2109

ABANDONED

KANSASPool Name WildcatMap No. 64 Sec. 16 Twp. 11 R. 24WWell No. 1 GarrettMadza & B & R Drlg. Company**FIRST REPORT** Contractor

SE NE

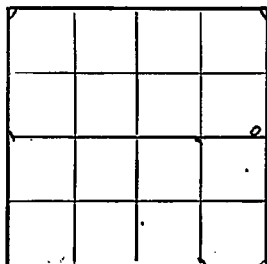SECTION PLAT Ft. from N. Line330 Ft. from S. Line330 Ft. from E. Line Ft. from W. LineTrego CountyLocation Rig up

Drilling and Remarks:

8" @ 210

Drlg. 1559'

RECORDCased in., ft.Sand Gas Oil Total Depth **PRODUCTION**1st 24 hrs. Nat. 1st 24 hrs. after shot Gas Cu. Ft.Dry Hole Abandoned

Date

AUG 28 1946 19 S. J. LEWIS Scout

Pool Name Wildcat

Kansas

Map No. 69 Sec. 16 Twp. 11 R. 24WWell No. 1 GarrettMazda & B & R Drlg. Company**ABANDONED**

Contractor

SE NE

E 1,2434
SECTION PLAT Ft. from N. Line330 Ft. from S. Line330 Ft. from E. Line Ft. from W. Line

			6

Trego CountyLocation Rig up

Drilling and Remarks:

Misc 4339
Vista 4485
Cer 4543

RECORDCased in, ft.Sand Gas Oil Total Depth 4573**PRODUCTION**1st 24 hrs. Nat. 1st 24 hrs. after shot Gas Cu. Ft.Dry Hole Abandoned

Date

SEP 11 1946 19

S. J. LEWIS

Scout