

Trego County

KANSAS


Form 51 5M 11-26 13898

Map No. *K* Sec. *16* Twp. *11^S* R. *24^W*

Well No. *1* **DAVIS** Farm

Key Marine Co. Company

NORTH

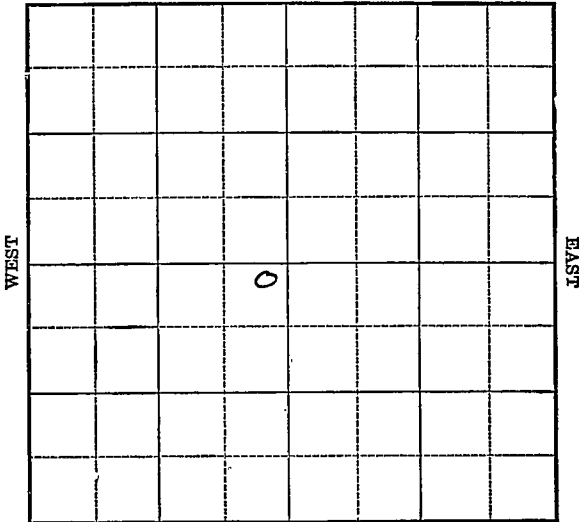

SOUTH

Location _____

Rig Up _____

Drilling Remarks:

Drilling Remarks:

RECORD

PRODUCTION

Cased _____ in. _____ ft.
 Sand _____
 Gas _____
 Oil _____
 Total Depth _____

1st 24 hrs. Nat. _____
 1st 24 hrs. after shot _____
 Gas _____ cu. ft.
 Dry Hole _____
 Abandoned _____

Map No. 76 Sec. 16 Twp. 11 **KANSAS** R. 24 ^W

Well No. 1 Farm


Key marine oil Company

200 Ft. from N. Line

_____ Ft. from S. Line

200 Ft. from E. Line

_____ Ft. from W. Line

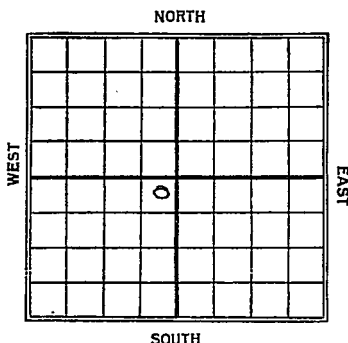

B

Date	REPORT
1924	
2/1	Timbers
4/24	_____
7/20	no report.
1925	
1/21	Location only
1925	
6/2	S.D. 3030
1926	
4/29	-
1926	
9/8	J.D. 3030 - S.D.
9/15	_____
9/22	_____
9/29	same
10/6	same
10/13	_____
10/20	_____
10/27	_____
11/3	J.D. 3030 - D. & A.

Map No. *11533* *Trego Co* Sec. *168* Twp. *11S* R. *24W*

Well No. *1*

Key. Marine oil Company

Contractor

FIRST REPORT

SECTION PLAT

200 Ft. from N. Line

_____ Ft. from S. Line

200 Ft. from E. Line

_____ Ft. from W. Line

	<i>0</i>		

Location _____

Rig up _____

Drilling and Remarks:

Timber

RECORD

Cased _____ in., _____ ft.

Sand _____

Gas _____

Oil _____

Total Depth _____

PRODUCTION

1st 24 hrs. Nat. _____

1st 24 hrs. after shot _____

Gas _____ Cu. Ft.

Dry Hole _____

Abandoned _____

Date

FEB *1924*

J. A. BENEAR

192

Scout

Map No. MISS Sec. 16 Twp. 11 R. 24N

Well No. 1 Harris

Keys-Marine Company

Contractor

SECTION PLAT

	0		

200 Ft. from N. Line

_____ Ft. from S. Line

200 Ft. from E. Line

_____ Ft. from W. Line

ABANDONED

Location _____

Rig up _____

Drilling and Remarks:

T 113030

DVA.

RECORD

Cased _____ in., _____ ft.

Sand _____

Gas _____

Oil _____

Total Depth _____

PRODUCTION

1st 24 hrs. Nat. _____

1st 24 hrs. after shot _____

Gas _____ Cu. Ft.

Dry Hole _____

Abandoned _____

Date

NOV 3 1926

S. J. LEWIS Scout

MAP No. _____ SEC. 16 TWP. 11S R. 24W

WELL No. 1 Lewis

Keays Bros & Machine COMPANY

CONTRACTOR

no wall wrap

SECTION PLAT

		0	

_____ FT. FROM N. LINE

_____ FT. FROM S. LINE

_____ FT. FROM E. LINE

_____ FT. FROM W. LINE

RECORD

LOCATION _____

CASED _____ IN. _____ FT.

RIG UP _____

SAND _____

DRILLING AND REMARKS:

GAS _____

OIL _____

TOTAL DEPTH 3260

PRODUCTION

1ST 24 HRS. NAT. _____

1ST 24 HRS. AFTER SHOT _____

GAS _____ CU. FT.

DRY HOLE

ABANDONED _____

DATE

7/21 192 5

SCOUT