

KANSAS

FORM 51 IOM 12-46 PETROL


Ellis County

Section 16 Township 11 Range 17-W

Well No. 1 Bemis

Company Nadel & Gussman

Bemis Pool

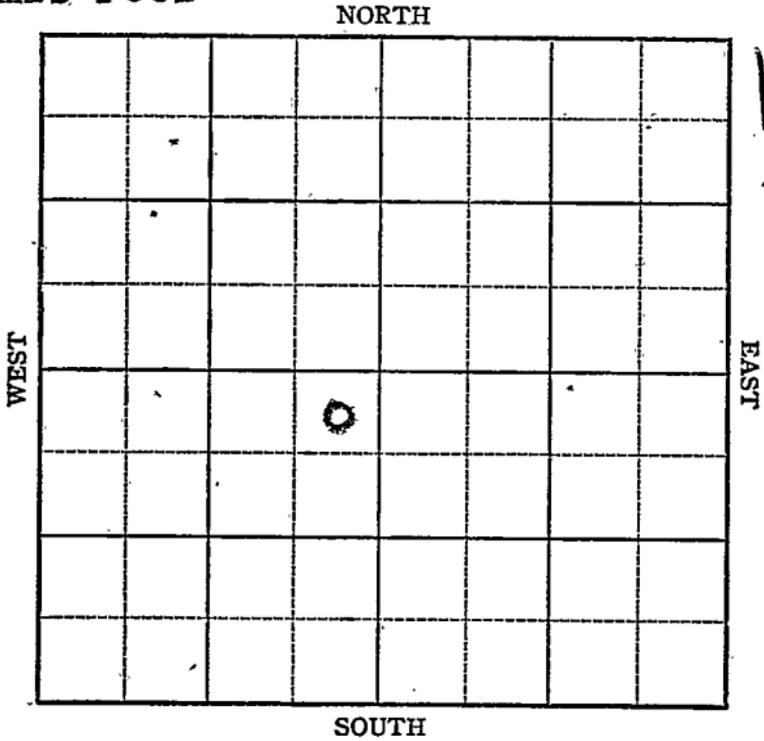

KANSAS

Sec. 16 Twp. 11 R. 17-W

Well No. #1 Bemis Farm _____

Nadel & Gussman Company


Bemis Pool

330 Ft. from N. Line

_____ Ft. from S. Line

330 Ft. from E. Line

_____ Ft. from W. Line

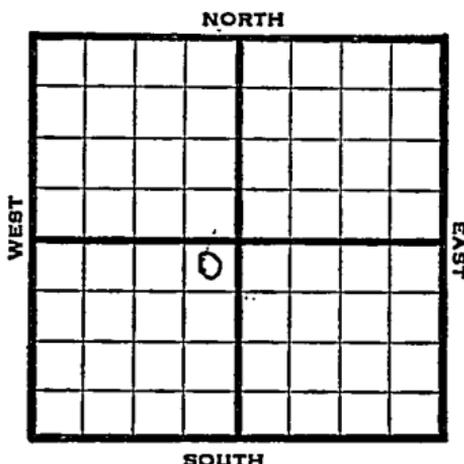

NE SW

1947 Elev. 1834' REPORT

7/2' Location

7/8 "

7-16 Surface hole

7/22 8" @ 896'
Drlg 2665'

7/30 Lens. 3036'
Arb. 3421'
TD 3440'

ABANDONED

Map No. _____ Sec. 16 Twp. 11 R. 17W

Well No. 1 Bemis

Nadel & Gussman Company

FIRST REPORT Contractor

NE SW


SECTION PLAT

330 Ft. from N. Line

_____ Ft. from S. Line

330 Ft. from E. Line

_____ Ft. from W. Line

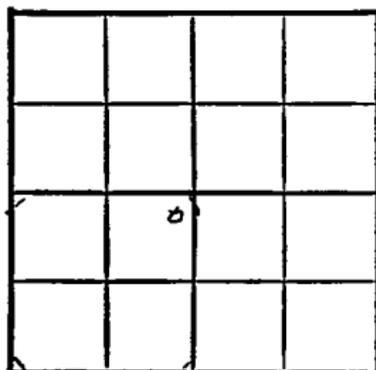

Ellis County

Location X

Rig up _____

Drilling and Remarks:

RECORD

Cased _____ in., _____ ft.

Sand _____

Gas _____

Oil _____

Total Depth _____

PRODUCTION

1st 24 hrs. Nat. _____

1st 24 hrs. after shot _____

Gas _____ Cu. Ft.

Dry Hole _____

Abandoned _____

Date

JUL 2 1947 19 _____

S. J. LEWIS Scout

Map No. 71 ~~Kansas~~ Sec. 16 Twp. 11 R. 17W

Well No. 1 Bemis

Nadel & Gussman Company

ABANDONED Contractor

NE SW

E11884
SECTION PLAT

330 Ft. from N. Line

_____ Ft. from S. Line

330 Ft. from E. Line

_____ Ft. from W. Line

	6		

Ellis County

Location _____

Rig up _____

Drilling and Remarks:

Lease 8086
CR 8342

RECORD

Cased _____ in., _____ ft.

Sand _____

Gas _____

Oil _____

Total Depth 3450

PRODUCTION

1st 24 hrs. Nat. _____

1st 24 hrs. after shot _____

Gas _____ Cu. Ft.

Dry Hole _____

Abandoned _____

Date

JUL 30 1947 19

S. J. LEWIS Scout