


Section 17 Township 11 Range 16W

Well No. #1 Chesney

Company Musgrove Petroleum

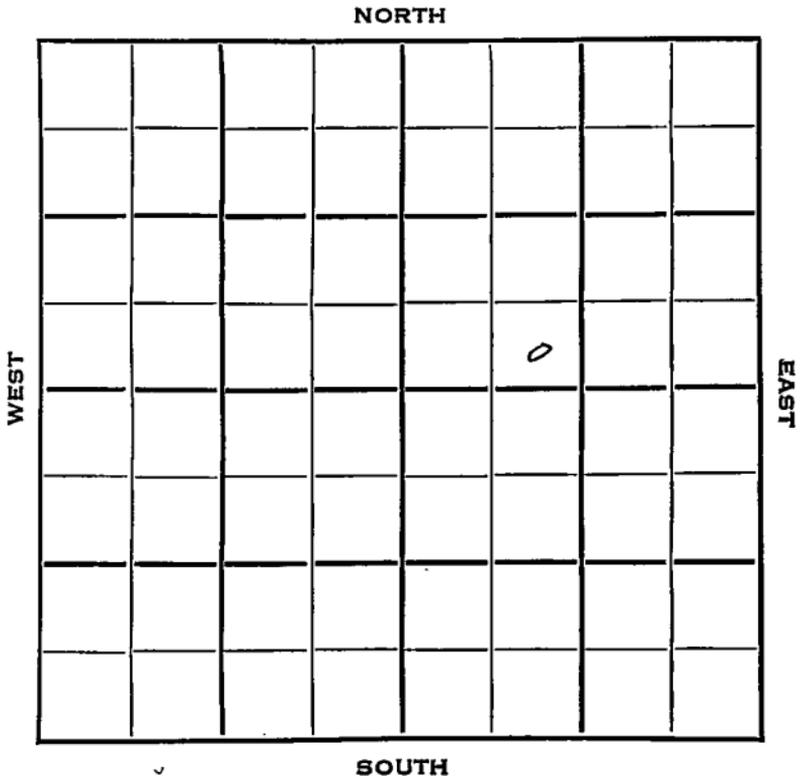

Sec. 17 Twp. 11 R. 16 W

Well No. # 1 Chesney Farm

Musgrove Pet. Company

Musgrove Contractor


\_\_\_\_\_ Ft. from N. Line

330 Ft. from S. Line

\_\_\_\_\_ Ft. from E. Line

990 Ft. from W. Line

SE SW NE

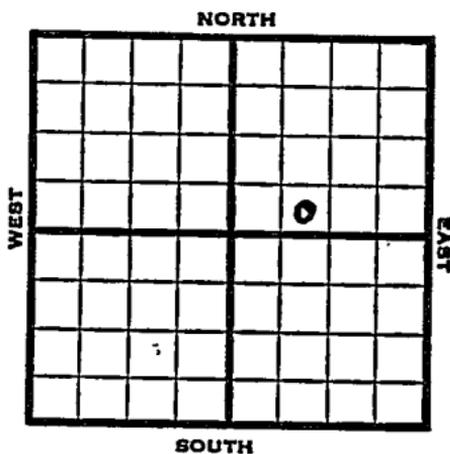

1953

Elev. 1776' REPORT

2/11

MIR

2/19

Drlg.

2/26

Tite hole

3/11

Spud 2-7-53 D & A TD 3415  
 8" @ 962 Top 2684 Heeb 2944  
 Tor 2969 Lans 2991  
 DST 3020-48 open 1 hr. rec 300' SW  
 780# B KC 3231 Cong 3282  
 Simp. 3331' Arb. 3367  
 TD 3415  
 D & A **ABANDONED**



