
FORM 51 25M 3-49 PETROL KANSAS Ellis

Section 17 Township 11 Range 16-W

Well No. #1 Chesney

Company H H Blair

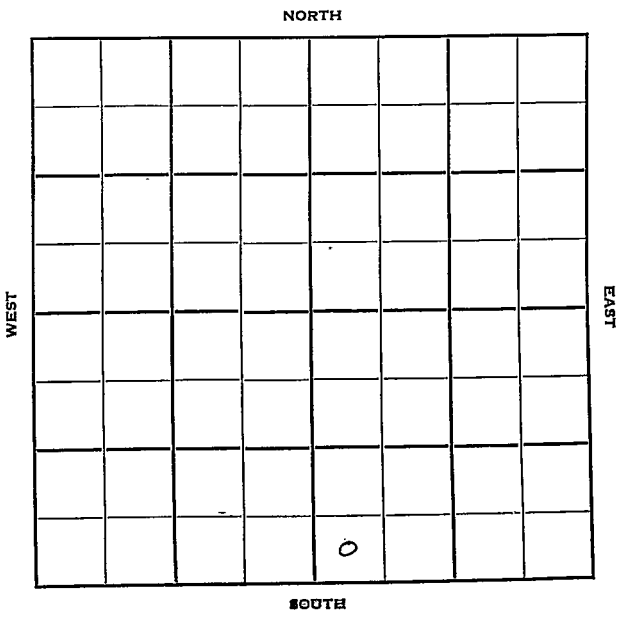

FORM 252-B
10M 9-49 PETROL

Ellis KANSAS

Sec. 17 Twp. 11 R. 16W

Well No. #1 Chesney Farm

H. H. Blair Company

H. H. Blair Contr.
Wildcat Contractor


Ft. from N. Line

330' Ft. from S. Line

Ft. from E. Line

330' Ft. from W. Line

SW SW SE

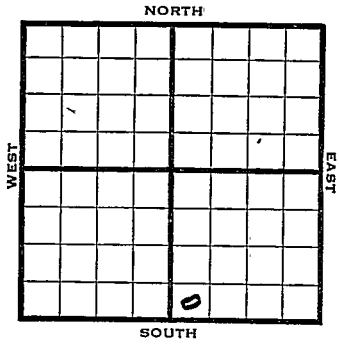

1950	Elev.1761' REPORT
8/23	Spud 8-19-50 Drlg. 900'
9/27	Spud 8-15-50 D&A TD 3359' Anhy 955-78 8" @ 985' Top 2666' Heeb 2926' Dodge 2951' Lans. 2969' DST 3014-26 opn 1 hr Rec. 10' OCM BKC 3224' Cong. 3259' Arb. 3338' DST 3339-48 opn30 min Rec. 46' SW Simp. 3329' TD 3359' D&A ABANDONED

FORM 275 FOR SALE BY KANSAS BLUE PRINT CO.


County Ellis State Kansas

Sec. 17 (Blk. / Twp.) 11 (Sur. / Rge.) 16W Map No.

Operator H. H. Blair

Well No. 1 Farm Chesney

Elev. Location SW SW SE

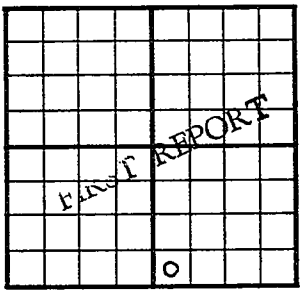

330 Ft. From S Line SE

330 Ft. From W Line Quarter

1st. Report AUG 2 3 1950

Completion

Remarks Skelly DHM

Spudding Date 8-19-50

Drlg. Data Wildcat

drlg. 900

J. E. TYRA

FORM 275 FOR SALE BY KANSAS BLUE PRINT CO.

~~Kansas~~


County Ellis State

Sec. 17 (Blk. Twp.) 11 (Sur. Rge.) 16W Map No.

Operator H. H. Blair

Well No. 1 Farm Chesney

Elev. 1761 Location SW SW SE

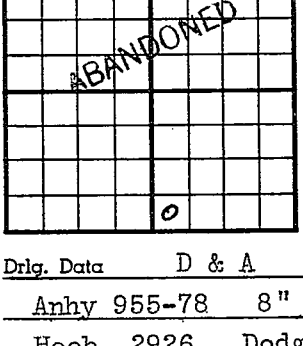

330 Ft. From S Line SE

330 Ft. From W Line Quarter

1st. Report

Completion SEP 27 1950

Remarks Wildcat

H.H. Blair - Contr.

Spudding Date 8-19-50

Drlg. Data D & A TD 3359

Anhy 955-78 8" @ 985 Top. 2666

Heeb. 2926 Dodge 2951 Lans. 2969

DST 3014-26 open 1 hr. Rec. 10' ocm

B KC 3224 Cong. 3259 Arb. 3338

DST 3339-48 open 30 min. Rec. 46' sw

Simp. 3329 TD 3359 D & A

J. E. TYRA