

KANSAS

FORM 51 5M PETROL


Ellis

Section 17 Township 11 Range 16-W

*LIEB*

Well No. #1 ~~B. E. Craig~~

Company Falcon-Seaboard

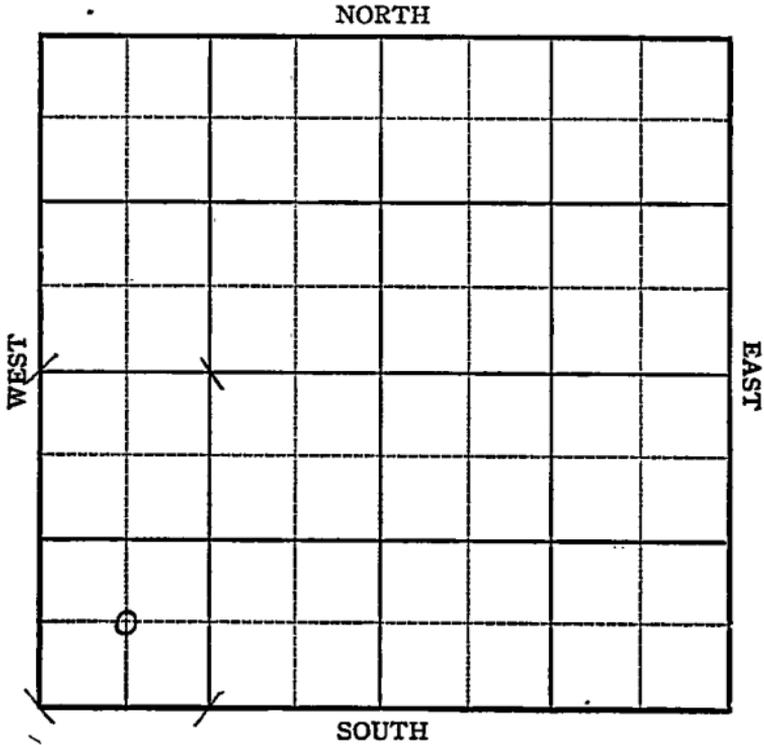

Sec. 17 Twp. 11 R. 16-W

Well No. #1 E. E. Craig Lieb Farm


Falcon-Seaboard Company

\_\_\_\_\_ Ft. from N. Line

660 Ft. from S. Line

\_\_\_\_\_ Ft. from E. Line

660 Ft. from W. Line

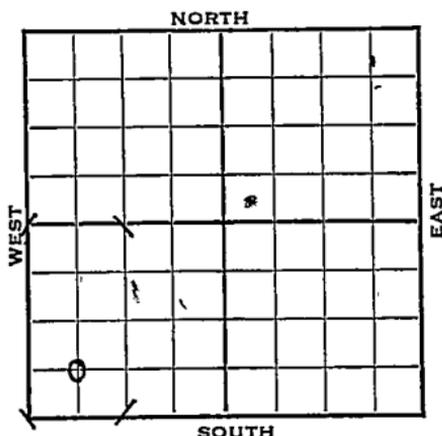

*Elev. 1765*

1943

REPORT

8/18	Derrick
8/25	"
9/1	"
9/8	"
9/15	"
9/22	"
9/29	"
10/6	"
10/13	"
10/20	"
10/27	"
11/3	"
11/10	Drk & tools
11/17	12" @ 70'
	Drlg. 780'
11/24	8" @ 870'
	Drlg. 1790'
12/1	Drlg. 2750'
12/8	Topeka 2705
	Lans 3009
	Drlg. 3240'

OVER

1943

12/15

~~6" @ 1274~~

~~Sand 1274~~

~~TD 1286~~

~~5,965,000 gas.~~

~~COMPLETED~~

1942

Cong 3267

Simp 3334

Arb 3339

TD 3370'

ABANDONED

Map No. 71 Sec. 17 Twp. 11 R. 16W

Well No. 1 E. E. Craig

Falcon-Seaboard Company

FIRST REPORT Contractor

**C SW SW**

\_\_\_\_\_ Ft. from N. Line

660 Ft. from S. Line

\_\_\_\_\_ Ft. from E. Line

660 Ft. from W. Line

**WILDCAT**

**SECTION PLAT**


**RECORD**

Location \_\_\_\_\_

Cased \_\_\_\_\_ in., \_\_\_\_\_ ft.

Rig up \_\_\_\_\_

Sand \_\_\_\_\_

Drilling and Remarks:

Gas \_\_\_\_\_

**Derrick**

Oil \_\_\_\_\_

Total Depth \_\_\_\_\_

**PRODUCTION**

1st 24 hrs. Nat. \_\_\_\_\_

1st 24 hrs. after shot \_\_\_\_\_

Gas \_\_\_\_\_ Cu. Ft.

Dry Hole \_\_\_\_\_

Abandoned \_\_\_\_\_

Date

AUG 1 8 1943 19\_\_\_\_\_

S. J. LEWIS Scout

KANSAS  
Map No. 77 Sec. 17 Twp. 11 R. 16W

Well No. 1 Lieb  
Falcon Seaboard Company  
CORRECTION Contractor

C SW SW

SECTION PLAT


         Ft. from N. Line  
660 Ft. from S. Line  
         Ft. from E. Line  
660 Ft. from W. Line

Wildcat

Location                                 

Rig up                                 

Drilling and Remarks:

Reported as  
#1 E. E. Craig

RECORD

Cased          in.,          ft.  
Sand                                   
Gas                                   
Oil                                   
Total Depth                         

PRODUCTION

1st 24 hrs. Nat.                           
1st 24 hrs. after shot                           
Gas                          Cu. Ft.  
Dry Hole                                   
Abandoned                                 

Date

NOV 3 1943 19 S. I. LEWIS Scout

Map No. KANSAS/ Sec. 17 Twp. 11 R. 16W

Well No. 1 Lieb

Falcon-Seaboard Company

ABANDONED Contractor

C SW SW

SECTION PLAT

o			

         Ft. from N. Line

660 Ft. from S. Line

         Ft. from E. Line

660 Ft. from W. Line

Wildcat

Location         

Rig up         

Drilling and Remarks:

*Core 3267*  
*Swamp 3334*  
*Re 3337*

RECORD

Cased          in.,          ft.

Sand         

Gas         

Oil         

Total Depth 3370

PRODUCTION

1st 24 hrs. Nat.         

1st 24 hrs. after shot         

Gas          Cu. Ft.

Dry Hole         

Abandoned         

Date

DEC 15 1943

19

S. J. LEWIS Scout