

Ottawa


FORM 51 IOM 12-46 PETROL

KANSAS

Section 17 Township 11 Range 2W

Well No. 1 Beverly

Company Westgate-Greenland

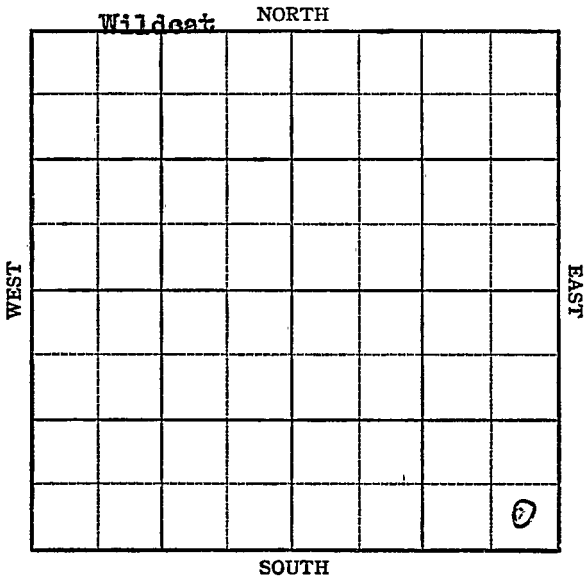

KANSAS

Ottawa

✓

Sec. 17 Twp. 11 R. 2W

Well No. #1 Beverly Farm

Westgate-Greenland Company

Wildcat

Ft. from N. Line

330


Ft. from S. Line

330

Ft. from E. Line

Ft. from W. Line

SE/c

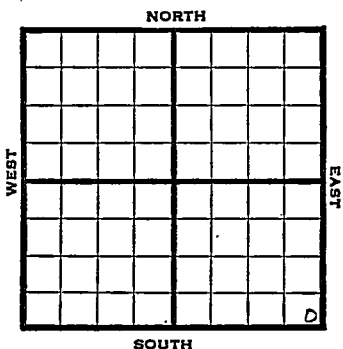

1947

Elev. 1813 REPORT

9/10

Location

9/17

8" @ 161'

Drig. 1245'

9/24

Drig. 2505'

10/1

Wiss. 2723

Hunton 3142

Viola 3283

Simp 3570

Perf 3613

TD 3644

ABANDONED

Map No. _____ Sec. 17 Twp. 11 R. 2W

Well No. 1 Beverly

Westgate-Greenland Company

FIRST REPORT

Contractor

SE/C


SECTION PLAT

_____ Ft. from N. Line

330 Ft. from S. Line

330 Ft. from E. Line

_____ Ft. from W. Line

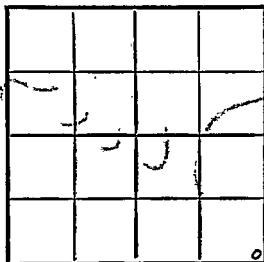

Ottawa County

Location X

Rig up _____

Drilling and Remarks:

NO APP

RECORD

Cased _____ in., _____ ft.

Sand _____

Gas _____

Oil _____

Total Depth _____

PRODUCTION

1st 24 hrs. Nat. _____

1st 24 hrs. after shot _____

Gas _____ Cu. Ft.

Dry Hole _____

Abandoned _____

Date

SEP 10 1947

19

S. J. LEWIS


Scout

Map No. 51 Sec. 17 Twp. 11 R. 2WWell No. 1 BeverlyWestgate-Greenland Company

ABANDONED

Contractor

SE/C

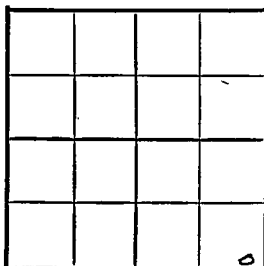E11813
SECTION PLAT Ft. from N. Line330 Ft. from S. Line330 Ft. from E. Line Ft. from W. Line

Ottawa County

Location Rig up

Drilling and Remarks:

Miss 2723^f
Hutton 3142
Vota 3283
Simp 3570
Per 3613

RECORD

Cased in., ft.Sand Gas Oil Total Depth 3644

PRODUCTION

1st 24 hrs. Nat. 1st 24 hrs. after shot Gas Cu. Ft.Dry Hole Abandoned

to

1947

19

S. J. LEWIS Scout