
FORM 51 5M BRIX **KANSAS** Russell County

Section 17 Township 11 Range 15W

Well No. #1 American Investment

Company Cap Rock Oil

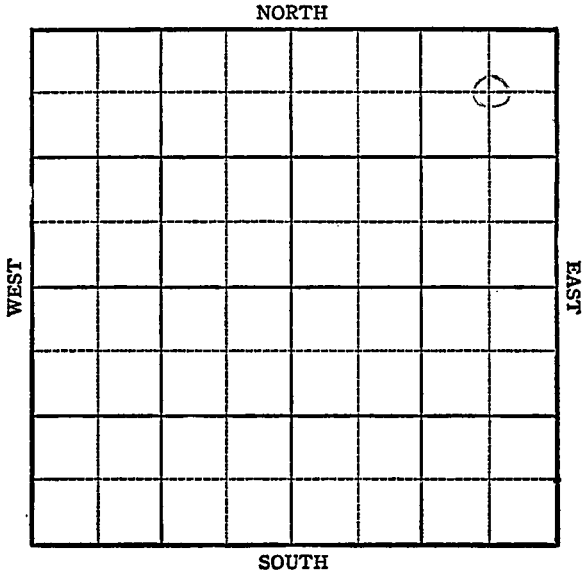

FORM 252-A
5M 9-44 PETROL

Russell County

KANSAS

Sec. 17 Twp. 11 R. 15W

Well No. #1 American Investment Farm

Cap Rock Oil Company


Fairport

660 Ft. from N. Line

Ft. from S. Line

Ft. from E. Line

660 Ft. from W. Line

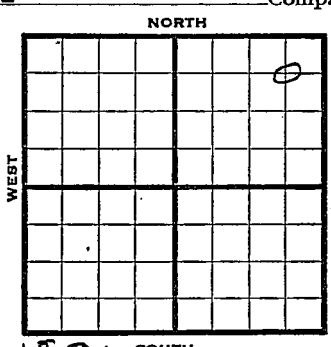

C NE NE Elev. 1890

1944	REPORT
11/15	Location
11/24	"
11/29	Cable rig
12/6	Tigging up
12/14	15" @ 384' Drlg. 525'
12/21	586 fsg.
12/29	12" @ 700, 10" @ 980 Co
1945	
1/3	Anhy 970 Drlg 1550
1/10	8" @ 2450 Drlg 2565
1/17	7" @ 3015 Drlg 3130
1/26	Drlg. 3200'
1/31	Lans 3130 Sooy 3348-51 TD 3351 1500' oil 8 hrs. UR 8"
2/7	Arb 3342 TD 3351 5" @ 3342 2000' oil
2/14	SD

OVER

FORM 56 200 BKS, 1-44 PETROL

Pool Name Fairport

Map No. 72 Sec. 17 Twp. 11 R. 15W

Well No. 1 American Investment


Cap Rock Oil Company

FIRST REPORT

Contractor

C NE NE

SECTION PLAT

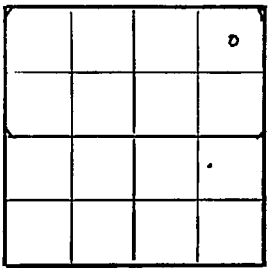

660 Ft. from N. Line

Ft. from S. Line

Ft. from E. Line

660 Ft. from W. Line

Russell

Location X

Rig up

Drilling and Remarks:

RECORD

Cased in., ft.

Sand

Gas

Oil

Total Depth

PRODUCTION

1st 24 hrs. Nat.

1st 24 hrs. after shot

Gas Cu. Ft.

Dry Hole

Abandoned

Date

NOV 15 1944 19 S. J. LEWIS Scout

FORM 56 200 BKS. 1-44 PETROL

Pool Name Fairport

Map No. 7 Sec. 17 Twp. 11 R. 15W

Well No. 1 American Investment

Cap Rock Oil Company

COMPLETED Contractor

C NE NE


660 Ft. from N. Line

____ Ft. from S. Line

____ Ft. from E. Line

660 Ft. from W. Line

SECTION PLAT

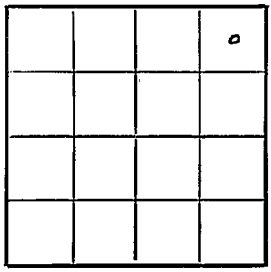

Russell County

Location

Rig up

Drilling and Remarks:

Sand 3348

5" @ 3342

Pump 100 B & X

39° Gr

RECORD

Cased ____ in., ____ ft.

Sand

Gas

Oil

Total Depth 3357

PRODUCTION

1st 24 hrs. Nat.

1st 24 hrs. after shot

Gas ____ Cu. Ft.

Dry Hole

Abandoned

Date

FEB 28 1945 19

S. J. LEWIS Scout

1945
2/21 No Arb. Sooy 3348 Corrected

2/28 Sooy 3348
5" @ 3342
Pump 100 Pot.
TD 3351
Gravity 39.0

COMPLETED