


Russell

Form 51-5M-5-34-Palace

Map No. **KANSAS** Sec. 17 Twp. 11 R. 15^w

Well No. J. Stewart Farm
Liggett et al Company

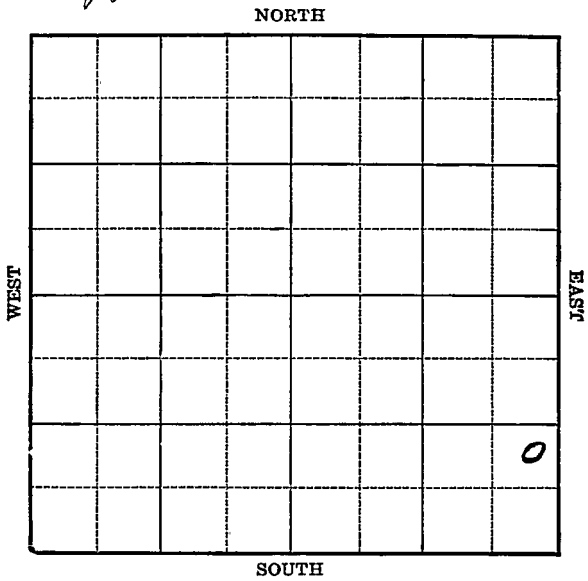

Location _____

Drilling Remarks _____

Rig Up _____

Drilling Remarks _____

RECORD

Cased _____ in. _____ ft.

Sand _____

Gas _____

Oil _____

Total Depth _____

PRODUCTION

1st 24 hrs. Nat. _____

1st 24 hrs. after shot _____

Gas _____ cu. ft.

Dry Hole _____

Abandoned _____

Map No. KANSAS Sec. 17 Twp. 11 R. 15^w


Well No. 1 Stewart Farm
Liggett et al Company

 Ft. from N. Line

990 Ft. from S. Line

330 Ft. from E. Line

 Ft. from W. Line

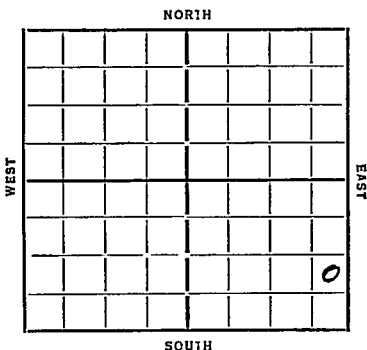

Date

REPORT

1934	
8/23	Cellar
8/30	—
9/6	B. R.
9/13	Rign up
9/19	— 9/27 —
10/4	Dly 385 20" 18
10/11	" 625
10/18	12 1/2 653 10" 971 T Selt 1520
10/25	Dly 1985
11/1	" 2080
11/8	5D 2085
11/15	— 11/22 —
11/28	Dly 2105
12/6	8" 2335
12/15	Dly 2740
12/21	S.O. 2750-60 2895 72g
12/27	— 1/3/35 —
1/10	6" 2982 Crawl 3007 50-3019
	S.O. 3030-35 HFW 3085-90 Dly 3152
1/17	— 1/24 —

(OVER)

Map No. 72 Sec. 17 Twp. 11 R. 15^W

Well No. 1 - Stewart

Liggett et al Company

Contractor

FIRST REPORTS

SECTION PLAT

_____ Ft. from N. Line

990 Ft. from S. Line

330 Ft. from E. Line

_____ Ft. from W. Line

			0

Location _____

Rig up _____

Drilling and Remarks:

cellar

RECORD

Cased _____ in., _____ ft.

Sand _____

Gas _____

Oil _____

Total Depth _____

PRODUCTION

1st 24 hrs. Nat. _____

1st 24 hrs. after shot _____

Gas _____ Cu. Ft.

Dry Hole _____

Abandoned _____

Date

8-13-27 19

ORVAL MANNSCHRECK
Scout

Map No. 77 Sec. 17 Twp. 11 R. 15W

Well No. 1-Stewart

Piggott et al Company

Contractor

COMPLETED

SECTION PLAT

..... Ft. from N. Line

990 Ft. from S. Line

330 Ft. from E. Line

..... Ft. from W. Line

			0

Location.....

Rig up.....

Drilling and Remarks:

201 lbs

RECORD

Cased..... in..... ft.

Sand Orval 3007

Gas.....

Oil.....

Total Depth 3243

PRODUCTION

1st 24 hrs. Nat.....

1st 24 hrs. after shot.....

Gas..... Cu. Ft.

Dry Hole.....

Abandoned.....

Date

ORVAL MANNSCHRECK

2-27-35 192.....

Scout

1/31 6" 3142 S.O. 3187
505 g 3197 T7 3228 Testing

2/7 T7 3241 Est 3 Bbls per hr.

2/14 —

2/21 3243 T7 Est 3 Bbls per hr.

2/27 Oswald 3007 T7 3243
201 Bbls.

COMPLETED