


Section 17 Township 11 Range 15-W


Well No. 2 Stewart

Company C. B. Liggett etal

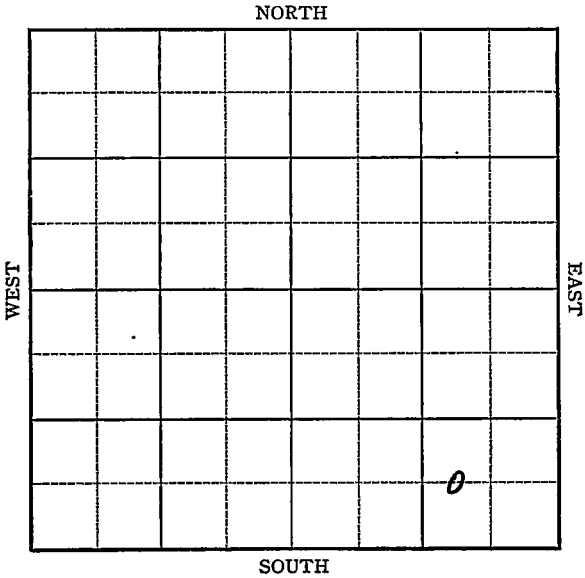

Sec. 17 Twp. 11 R. 15-WWell No. #2 Stewart FarmC. B. Liggett et al Company
(Fairport) Ft. from N. Line660 Ft. from S. Line990 Ft. from E. Line Ft. from W. Line

Elev. 1881

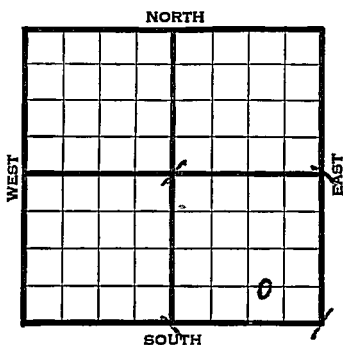

1941

REPORT

7/9-

Cable.

7/17

"

7/24

"

7/31

Rigging up

8/7

"

8/15

15½" @ 390'

540 TD Run 12"

8/21

15" - 411' 12" - 648'

10" - 964' Drlg. 1275'

8/28

Drlg. 2100'

9/4

8" - 2528' Drlg. 2534'

9/11

8" - 2708' Topeka 2708'

Drlg. 2800'

9/18

SS0 & 1 B.W. 2910-24'

Dodge 2955' Lans. 2995'

SS0 3012-15' 1 B0 3020-25'

7" - 3071' SO & 5 BW 3082-85'

HFW 3085-87' Drlg. 3100'

9/25

S.O. 3186-90' 7" - 3237'

Drlg. 3282'


10/2

SD 3282'

10/9

"

OVER

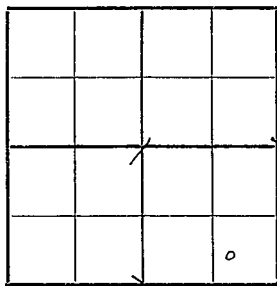Map No. 72 Sec. 17 Twp. 11 R. 15WWell No. 2 StewartC. B. Liggett et al CompanyFIRST REPORT ContractorC W L SE SEFt. from N. Line660 Ft. from S. Line990 Ft. from E. LineFt. from W. Line**FAIRPORT POOL****SECTION PLAT**

Location _____

Rig up _____

Drilling and Remarks:

Cable**RECORD**

Cased _____ in., _____ ft.

Sand _____

Gas _____

Oil _____

Total Depth _____

PRODUCTION

1st 24 hrs. Nat. _____

1st 24 hrs. after shot _____

Gas _____ Cu. Ft.

Dry Hole _____

Abandoned _____

Date

JUL 9 194119S. J. LEWIS Scout

Map No. K-22 Sec. 17 Twp. 11 R. 15WWell No. 2 StewartC. B. Liggett et al CompanyCOMPLETED Contractor

C W L SE SE

 Ft. from N. Line660 Ft. from S. Line990 Ft. from E. Line Ft. from W. Line

SECTION PLAT

			o

FAIRPORT POOL

Location Rig up

Drilling and Remarks:

Lions 2990Cr 833557" C3250PB 325024 shots to 3189-954000 acialPump 58 P & X30" 1/2"

Date

RECORD

Cased in., ft.Sand Gas Oil Total Depth 3383

PRODUCTION

1st 24 hrs. Nat. 1st 24 hrs. after shot Gas Cu. Ft.Dry Hole Abandoned

OCT 15 1941

S. J. LEWIS

Scout

1941

10/15

Lans. 2990'

Arb. 3355'

7" - 3250'

T.D. 3383'

P.B. to 3250'

24 shots 3189-95'

4000 acid.

Potential 58 bbls., pump.

35. Gravity

COMPLETED