


Section 17 Township 11 Range 18W

Well No. 1 Richards

Company H. H. & B. Drlg.

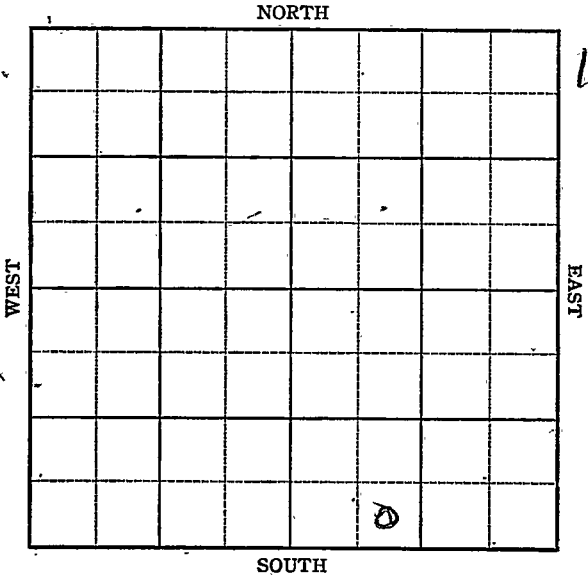

Sec. 17 Twp. 11 R. 18W

Well No. 1 Richard Farm


H. H. & B. Drlg. Company

~~970~~ Ft. from N. Line

330 Ft. from S. Line

~~990~~ Ft. from E. Line

990 Ft. from W. Line

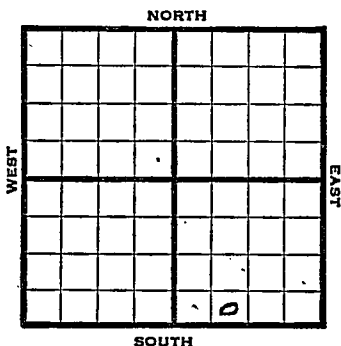

SE SW SE

1947 Elev. 1893' REPORT

6/4 Location

6/10 Drlg. 650'

6/21 8" @ 1018'
Drlg 3045'

6/24 Lansing 3148'
Arbuckle 3465'
T.D. 3471'
5" @ 3465'
RUST

7/2 Arb. 3465'
5" @ 3465'
Lans. 3148'
TD 3471'

ABANDONED

Kansas

Map No. 71 Sec. 17 Twp. 11 R. 18W

Well No. 1 Richard

H. H. & B. Drlg. Company

ABANDONED

Contractor

SE SW SE

E. I. 1893

SECTION PLAT

_____ Ft. from N. Line

330 Ft. from S. Line

_____ Ft. from E. Line

990 Ft. from W. Line

Ellis County

Location _____

Rig up _____

Drilling and Remarks:

Cor 83465
5103465
Leas 8148

RECORD

Cased _____ in., _____ ft.

Sand _____

Gas _____

Oil _____

Total Depth 8471

PRODUCTION

1st 24 hrs. Nat. _____

1st 24 hrs. after shot _____

Gas _____ Cu. Ft.

Dry Hole _____

Abandoned _____

Date

JUL 2 1947 19

S. J. LEWIS Scout

Map No. 71 Sec. 17 Twp. 11 R. 18W

Well No. 1 Richards

H. H. & B. Drlg. Company

CORRECTION

Contractor

SE SW SE


_____ Ft. from N. Line

330 Ft. from S. Line

_____ Ft. from E. Line

990 Ft. from W. Line

SECTION PLAT

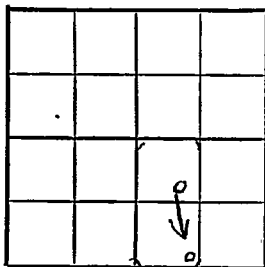

Ellis County

Location _____

Rig up _____

Drilling and Remarks:

Had spotted

SE NW SE

RECORD

Cased _____ in., _____ ft.

Sand _____

Gas _____

Oil _____

Total Depth _____

PRODUCTION

1st 24 hrs. Nat. _____

1st 24 hrs. after shot _____

Gas _____ Cu. Ft.

Dry Hole _____

Abandoned _____

Date

JUN 4 1947 19

S. J. LEWIS Scout

Kansas

Map No. _____ Sec. 17 Twp. 11 R. 18WWell No. 1 RichardH. H. & B. Drlg. CompanyFIRST REPORT Contractor

SE SW SE

990 Ft. from N. Line

_____ Ft. from S. Line

990 Ft. from E. Line990 Ft. from W. Line

SECTION PLAT

Ellis County

Location E

Rig up _____

Drilling and Remarks:

RECORD

Cased _____ in., _____ ft.

Sand _____

Gas _____

Oil _____

Total Depth _____

PRODUCTION

1st 24 hrs. Nat. _____

1st 24 hrs. after shot _____

Gas _____ Cu. Ft.

Dry Hole _____

Abandoned _____

Date

JUN 4 1947 19S. J. LEWIS Scout