


Section 17 Township 11 Range 19W

Well No. #3 Gunther

Company N C R A

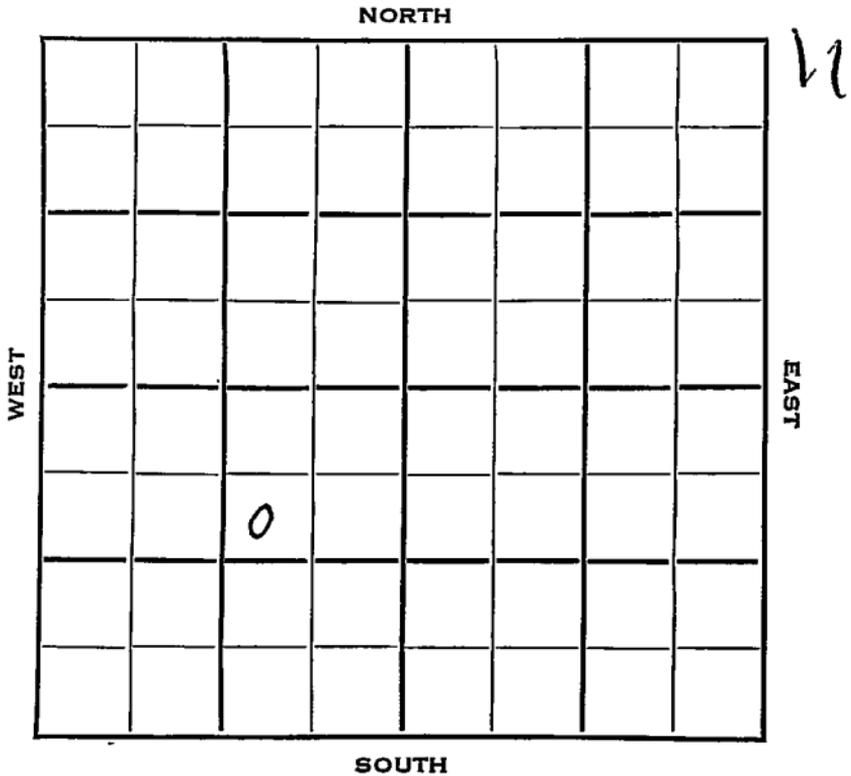

Sec. 17 Twp. 11 R. 19W

Well No. #3 Gunther Farm \_\_\_\_\_

N C R A Company \_\_\_\_\_

Contractor \_\_\_\_\_


990 Ft. from N. Line

\_\_\_\_\_ Ft. from S. Line

990 Ft. from E. Line

\_\_\_\_\_ Ft. from W. Line

SW NE SW

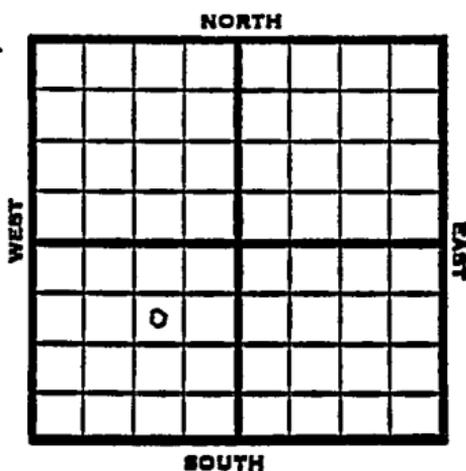

1953

Elev. 2005' REPORT

7/8

Spud 7-2-53  
8" @ 264  
Drlg. 2635'

7/22

Spud 7-2-53 D & A TD 3593  
8" @ 264 Anhy 1025 Top. 2995  
Heeb 3216 Lens 3254  
DST 3270-94 open 2 hr rec 45' SOCM  
930#  
DST 3311-41 open 2 hr rec 120' SOGSW  
60' SW 1180#  
DST 3412-34 open 2 hr rec 6' mud Off  
DST 3443-72 open 2 hr rec 37' SW  
1030# Marm. 3504' Cong. 3526'  
Simp. 3566 Arb. 3578  
~~TD~~ TD 3593'  
B & A

**ABANDONED**



