

Section 17 Township 11 Range 17W

Well No. 5 Mock

Company Champlin Ref.

NORTH

				0			

2

WEST

EAST

SOUTH

Sec. 17 Twp. 11 R. 17 W

Well No. # 5 Mock Farm

Champlin Ref. Company

Champlin Contractor


330 Ft. from N. Line

_____ Ft. from S. Line

_____ Ft. from E. Line

330 Ft. from W. Line

NW NW NE

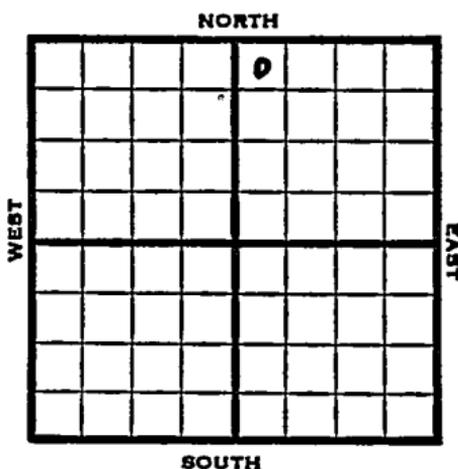

1952	Elev. 1825' REPORT
12/30	RUR
1/1	RUR
1/8	8" @ 1053 Anhy 1053 TOP 2780 DST 2768-80 1/2 hr. 30' M 970# Heeb 3010 Lans. 3052 Ø3060
1/22	DST 3196-3220, 1/2 hr, 12' M Cong. 3300' DST 3298-3320, 1/2 hr, 15' M 670# Simp 3429' Arb. 3462' RTD 3465' Schl 5" @ 3463 CO 3465 S/30 BFPH 75% wtr.
1/29	S/10 BO + 21 BWPB 6 hrs., POP
2/5	NR
2/12	NR
2/19	NR
2/26	NR
3/3	Spud 12-29-52 Oil Well TD 3465 8" @ 1053 Anhy 1053, Top 2780 DST 2968-80, opn 1/2 hr., rec. 30' mud, 970# Heeb 3010, Lans 3052 DST 3176-3220; opn 1/2 hr., rec. 12' mud, 0# Cong 3300
	OVER

#5 Mock

I (Information Brought Forward)

1953

3/4 DST 3298-3320, opn $\frac{1}{2}$ hr., rec.
15' mud, 670#
Simp 3429, Arb 3462
TD 3465
5' @ 3463,
CO to 3465 S/30 bfph 75% wtr.
S/10 bo 21 bwph 6 hrs.
Comp. 81 bopd 75% wtr.

COMPLETED

County Ellis State Kansas

Sec. 17 (Blk. Twp.) 11 (Sur. Rge.) 17W Map No.

Operator Champlin Ref.

Well No. 5 Farm Mock

Elev. _____ Location NW NW NE

FIRST REPORT

330 Ft. From N Line NE

330 Ft. From W Line Quarter

1st. Report DEC 30 1952

Completion _____

Remarks _____

Champlin - Contr.

Spudding Date _____

Drlg. Data _____

R U R

Scout Cards

mm

JAN 2 1953

Land Small Map

Land Small Map

3

Tracings

France Map

Pierce Map

Misc.

Orig. Data

MAR 11 1953

Scout Cards	10
Land Small Map	
Land Wall Map	3
Tracings	
France Map	
Pierce Map	
Misc.	

Drig. Data