

KANSAS

Ellis


Form 51-5M-7-40-Palace

Section 17 Township 11 Range 17-W

Well No. 2 Carmichael "C"

Company Dickey Oil

Bemis Pool

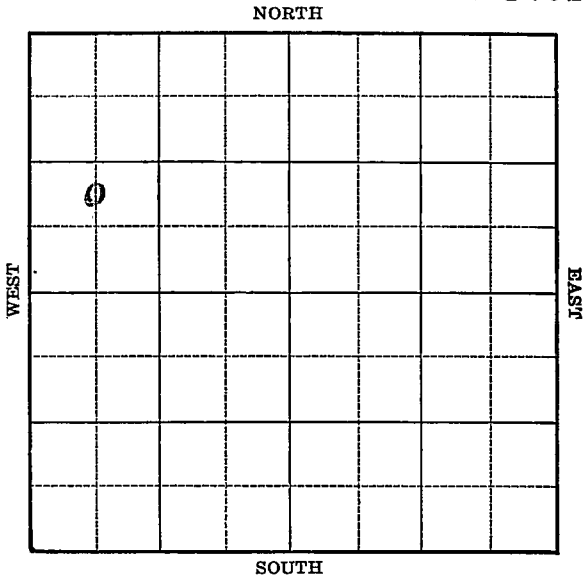

Sec. 17 Twp. 11 R. 17-W

Well No. #2 Carmichael "C" Farm

Dickey Oil Company

(Bemis)


_____ Ft. from N. Line

990 Ft. from S. Line

_____ Ft. from E. Line

660 Ft. from W. Line

Elev. 1843

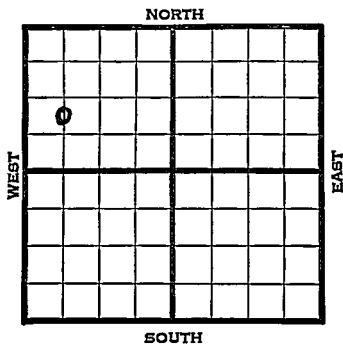

REPORT	
1941	
4/2	Derrick.
4/10	"
4/18	"
4/24	"
5/1	"
5/8	"
5/15	15" - 43' Anhy. 1087'
	10" - 1108' WOC.
5/22	Drlg. 2888'
5/28	Arb. 3346 -47' T.D. 7" - 3346'
	RUST.
6/2	Arb. 3346'
	7" - 3346'
	T.D. 3356'
	Echometer potential 4782 bbls.
	Maximum 3000 bbls.
	33.5 Gravity
	COMPLETED

Map No. 71 Sec. 17 Twp. 11 R. 17WWell No. 2 Carmichael "C"

Dickey Oil

Company

FIRST REPORT

Contractor

C N L SW NW

_____ Ft. from N. Line

990 Ft. from S. Line

_____ Ft. from E. Line

660 Ft. from W. Line

BEMIS POOL

SECTION PLAT

o			

Location _____

Rig up _____

Drilling and Remarks:

Derrick

RECORD

Cased _____ in., _____ ft.

Sand _____

Gas _____

Oil _____

Total Depth _____

PRODUCTION

1st 24 hrs. Nat. _____

1st 24 hrs. after shot _____

Gas _____ Cu. Ft.

Dry Hole _____

Abandoned _____

Date

APR 2 1941 19

S. J. LEWIS Scout

Map No. 71 Sec. 17 Twp. 11 R. 17WWell No. 2 Carmichael "C"Dickey Oil CompanyCOMPLETED Contractor

C N L SW NW

_____ Ft. from N. Line

990 Ft. from S. Line

_____ Ft. from E. Line

660 Ft. from W. Line

BEMIS POOL

SECTION PLAT

o			

Location _____

Rig up _____

Drilling and Remarks:

Cu 83467" @ 3346Echo P 4782Map 2500335 Gr

RECORD

Cased _____ in., _____ ft.

Sand _____

Gas _____

Oil _____

Total Depth 3356

PRODUCTION

1st 24 hrs. Nat. _____

1st 24 hrs. after shot _____

Gas _____ Cu. Ft.

Dry Hole _____

Abandoned _____

Date

JUN 4 1941S. J. LEWIS Scout