

KANSAS

Ellis

FORM 51 5M 4-41 PETROL


Section 17 Township 11 Range 17-W

Well No. 8 Carmichael "C"

Company Dickey Oil

Bemis Pool

NORTH

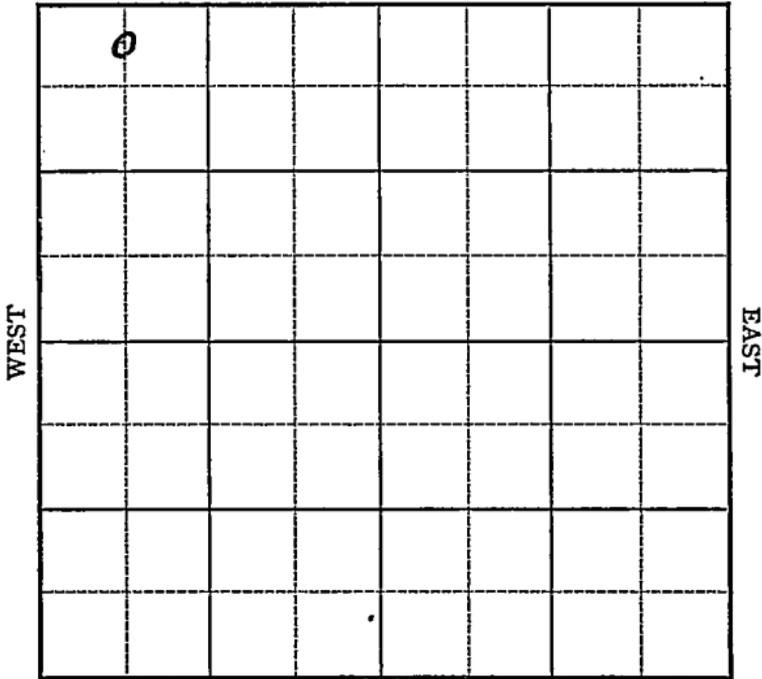

SOUTH

Sec. 17 Twp. 11 R. 17-W

Well No. #8 Camichaea "C" Farm

Dickey Oil Company

(Bemis)


330 Ft. from N. Line

_____ Ft. from S. Line

_____ Ft. from E. Line

660 Ft. from W. Line

Elev. 1838

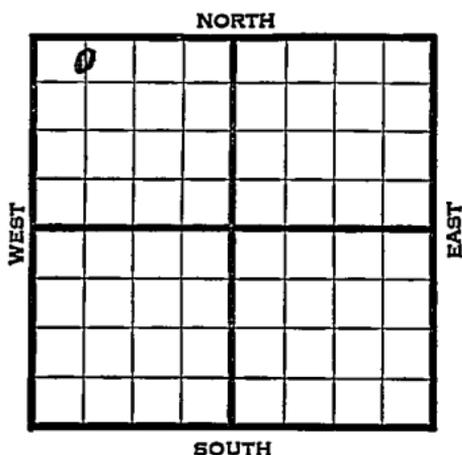

1941	REPORT
8/20	Derrick.
8/28	Rotary.
9/4	15" - 40' Anhy 1078'
	10" - 1088' WOC.
9/11	Drlg. 2800'
9/18	Arb. 3361-62' T.D. 7" - 3361'
	RUST.
9/24	Arb. 3361'
	7" - 3361'
	T.D. 3371'
	500 acid.
	Echometer potential 19,779 bbls.
	Maximum 3000 bbls.
	33.5 Gravity
	COMPLETED

Map No. 71 Sec. 17 Twp. 11 R. 17W

Well No. 8 Carmichael "C"

Dickey Oil

Company

FIRST REPORT

Contractor

C N L NW NW

SECTION PLAT

330 Ft. from N. Line

_____ Ft. from S. Line

_____ Ft. from E. Line

660 Ft. from W. Line

0			

BEMIS POOL

Location _____

Rig up _____

Drilling and Remarks:

Derrick

RECORD

Cased _____ in., _____ ft.

Sand _____

Gas _____

Oil _____

Total Depth _____

PRODUCTION

1st 24 hrs. Nat. _____

1st 24 hrs. after shot _____

Gas _____ Cu. Ft.

Dry Hole _____

Abandoned _____

Date

AUG 20 1941 19

S. J. LEWIS Scout

Map No. K-71 Sec. 17 Twp. 11 R. 17W

Well No. 8 Carmichael "C"

Dickey Oil Company

~~COMPLETED~~ Contractor

SECTION PLAT

0			

C N L NW NW
330 Ft. from N. Line
 _____ Ft. from S. Line
 _____ Ft. from E. Line
660 Ft. from W. Line

BEMIS POOL

Location _____

Rig up _____

Drilling and Remarks:

Cr & 8361
7" C 3361
500 acid
Echo 80819779
Max 3000

335 GW

RECORD

Cased _____ in., _____ ft.
 Sand _____
 Gas _____
 Oil _____
 Total Depth 3371

PRODUCTION

1st 24 hrs. Nat. _____
 1st 24 hrs. after shot _____
 Gas _____ Cu. Ft.
 Dry Hole _____
 Abandoned _____

Date

SEP 24 1941 19

S. J. LEWIS Scout