

KANSAS

FORM 51 5M 4-41 PETROL

Ellis


Section 17 Township 11 Range 17-W

Well No. 7 Carmichael "C"

Company Dickey Oil

Bemis pool

NORTH

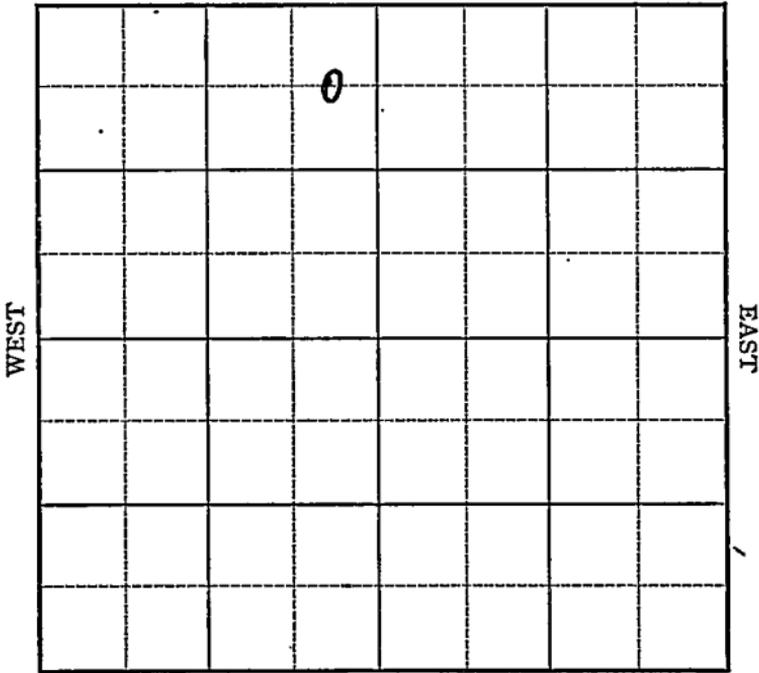

SOUTH

Map No. 71 Sec. 17 Twp. 11 R. 17W

Well No. 7 Carmichael "C"

Dickey Oil Company

FIRST REPORT Contractor

SECTION PLAT

C E L N E N W

	o		

660 Ft. from N. Line

_____ Ft. from S. Line

330 Ft. from E. Line

_____ Ft. from W. Line

BEMIS POOL

Location _____

Rig up _____

Drilling and Remarks:

Rigging up Rotary

RECORD

Cased _____ in., _____ ft.

Sand _____

Gas _____

Oil _____

Total Depth _____

PRODUCTION

1st 24 hrs. Nat. _____

1st 24 hrs. after shot _____

Gas _____ Cu. Ft.

Dry Hole _____

Abandoned _____

Date

AUG 13 1941

19

S. J. LEWIS Scout

Map No. 71 Sec. 17 Twp. 11 R. 17W

Well No. 7 Carmichael "C"

Dickey Oil Company

COMPLETED Contractor

C E L N E N W

SECTION PLAT

660 Ft. from N. Line

_____ Ft. from S. Line

330 Ft. from E. Line

_____ Ft. from W. Line

BEMIS POOL

Location _____

Rig up _____

Drilling and Remarks:

Cell # 3369
7" @ 3369
Echo P # 5483
Max 3000
335 Yr

RECORD

Cased _____ in., _____ ft.

Sand _____

Gas _____

Oil _____

Total Depth 3323

PRODUCTION

1st 24 hrs. Nat. _____

1st 24 hrs. after shot _____

Gas _____ Cu. Ft.

Dry Hole _____

Abandoned _____

Date

SEP 3 1941 19

S. J. LEWIS

Scout