


Section 17 Township 11 Range 17-W

Well No. #4 Carmichael "C"

Company Dickey Oil

NORTH Bemis pool

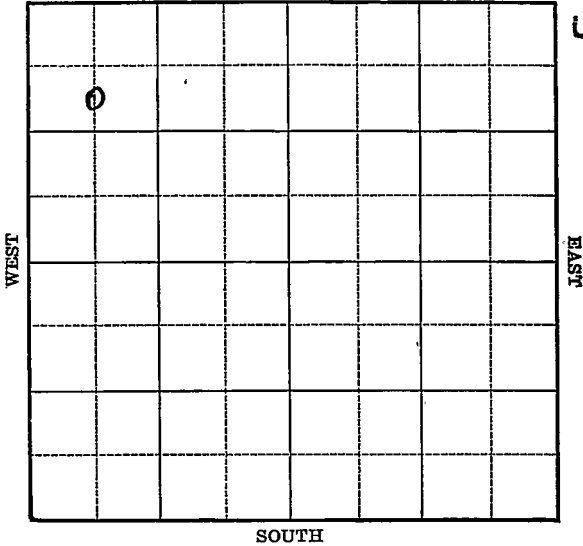

Sec. 17 Twp. 11 R. 17-W

Well No. #4 Carmichael "G" Farm

Dickey Oil Company

(Bemis)


990 Ft. from N. Line

_____ Ft. from S. Line

_____ Ft. from E. Line

660 Ft. from W. Line

Elev. 1839

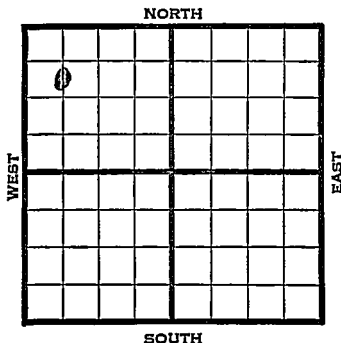

1941	REPORT
5/14	Derrick.
5/22	" "
5/28	Rotary.
6/5	15" - 35' Anhy 1078'
	10" - 1094' Drlg. 1234'
6/12	Drlg. 2700'
6/16	Drlg. 3290'
6/26	Arb. 3352 $\frac{1}{2}$ ' T.D. 3355'
	7" - 3352 $\frac{1}{2}$ ' RUST.
7/1	Arb. 3352 $\frac{1}{2}$ '
	7" - 3352 $\frac{1}{2}$ '
	T.D. 3355'
	Echometer potential 23000 bbls.
	Maximum 3000 bbls.
	33.5 Gravity
	COMPLETED

Map No. 7/ Sec. 17 Twp. 11 R. 17WWell No. 4 Carmichael "C"Dickey Oil Company~~FIRST REPORT~~ Contractor**SECTION PLAT****C S L NW NW**990 Ft. from N. Line Ft. from S. Line Ft. from E. Line660 Ft. from W. Line**BEMIS POOL**

o			

Location Rig up

Drilling and Remarks:

Derrick**RECORD**Cased in., ft.Sand Gas Oil Total Depth **PRODUCTION**1st 24 hrs: Nat. 1st 24 hrs. after shot Gas Cu. Ft.Dry Hole Abandoned

Date

MAY 14 1941 19S. J. LEWIS Scout

KANSAS

Map No. _____ Sec. 17 Twp. 11 R. 17W

Well No. 4 Carmichael "C"

Dickey Oil

Company

COMPLETED

Contractor

C S L NW NW

SECTION PLAT

990 Ft. from N. Line

_____ Ft. from S. Line

_____ Ft. from E. Line

660 Ft. from W. Line

o			

BEMIS POOL

Location _____

Rig up _____

Drilling and Remarks:

*Cor + 3352 1/2**7" @ 3352 1/2**Ech. Prod. 28000 ft**Nov 3000**335/32*

RECORD

Cased _____ in., _____ ft.

Sand _____

Gas _____

Oil _____

Total Depth *3355*

PRODUCTION

1st 24 hrs. Nat. _____

1st 24 hrs. after shot _____

Gas _____ Cu. Ft.

Dry Hole _____

Abandoned _____

Date

JUL 1 1941 19

S. J. LEWIS Scout