

# KANSAS

Form 51-5M-7-40-Palace


Ellis

Section 17 Township 11 Range 17-W

Well No. #1 Carmichael "C"

Company Dickey Oil

NORTH Bemis Pool

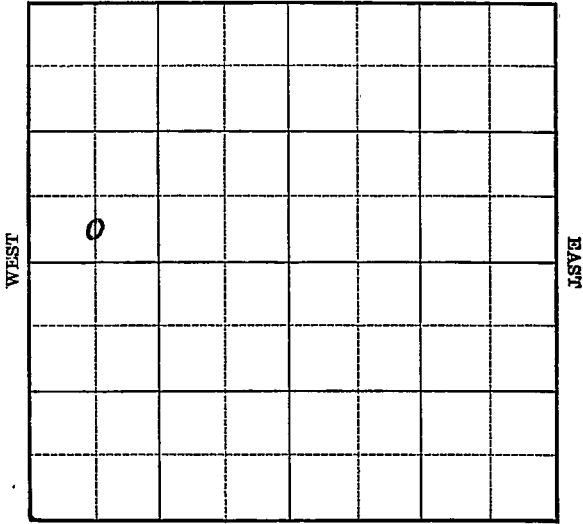

5

Sec. 17 Twp. 11 R. 17-W

Well No. #1 Carmichael "C" Farm

Dickey Oil Company


(Bemis)

\_\_\_\_\_ Ft. from N. Line

330 Ft. from S. Line

\_\_\_\_\_ Ft. from E. Line

66-0 Ft. from W. Line

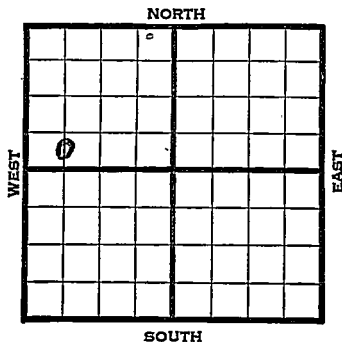

Elev. 1857

1941	REPORT
2/5	Location
3/13	Derrick.
3/20	15" - 60' Drlg. 400'
3/27	SD 1115'
4/3	Anhy 1099' 10" - 1124'
	Drlg. 1750'
4/10	Drlg. 3000'
4/18	Cong. 3336' Simp. shale 3345'
	Simp. sand 3358'
	Arb. 3359 -60' T.D. 7" - 3359'
	WOC.
	<b>OVER</b>

1941

4/23

Arb. 3359'

7" - 3359'

T.D. 3375'

Echometer potential 17,648 bbls.

Maximum 3000 bbls.

33.5 Gravity

COMPLETED

Map No. 71 Sec. 17 Twp. 11 R. 17W

Well No. 1 Carmichael "G"

Dickey Oil Company

FIRST REPORT Contractor

**SECTION PLAT**

C S L SW NW


\_\_\_\_\_ Ft. from N. Line

330 Ft. from S. Line

\_\_\_\_\_ Ft. from E. Line

660 Ft. from W. Line

BEMIS POOL

Location X

Rig up \_\_\_\_\_

Drilling and Remarks:

**RECORD**

Cased \_\_\_\_\_ in., \_\_\_\_\_ ft.

Sand \_\_\_\_\_

Gas \_\_\_\_\_

Oil \_\_\_\_\_

Total Depth \_\_\_\_\_

**PRODUCTION**

1st 24 hrs. Nat. \_\_\_\_\_

1st 24 hrs. after shot \_\_\_\_\_

Gas \_\_\_\_\_ Cu. Ft.

Dry Hole \_\_\_\_\_

Abandoned \_\_\_\_\_

Date

MAR 5 1941 19

S. J. LEWIS Scout

Misc. Small Maps *DAM*  
 Cards *Hand*  
 Tracing *Geo*  
 France Map *Geo*  
 Scarborough Map *Geo*  
 Cody Map *Geo*  
 Geological Dept. *Geo*  
 Mundy Plot Book

Map No. 71 Sec. 17 Twp. 11 R. 17W

Well No. 1 Carmichael "C"

Dickey Oil Company

~~COMPLETED~~ Contractor

C S L SW NW

**SECTION PLAT**


\_\_\_\_\_ Ft. from N. Line

330 Ft. from S. Line

\_\_\_\_\_ Ft. from E. Line

660 Ft. from W. Line

BEMIS POOL

Location \_\_\_\_\_

Rig up \_\_\_\_\_

Drilling and Remarks:

*Core 8359*

*7" @ 3359*

*Echo P 17648*

*May 3000*

*33.5 Gr.*

**RECORD**

Cased \_\_\_\_\_ in., \_\_\_\_\_ ft.

Sand \_\_\_\_\_

Gas \_\_\_\_\_

Oil \_\_\_\_\_

Total Depth 3325

**PRODUCTION**

1st 24 hrs. Nat. \_\_\_\_\_

1st 24 hrs. after shot \_\_\_\_\_

Gas \_\_\_\_\_ Cu. Ft.

Dry Hole \_\_\_\_\_

Abandoned \_\_\_\_\_

Date

APR 23 1941 19

S. J. LEWIS Scout

Misc. Small Maps ..... *Paul*  
Cards ..... *Paul*  
Tracing ..... *Jim*  
France Map ..... *Paul*  
Scarborough Map ..... *Paul*  
Moody Map ..... *Jim*  
Geological Dept. ....  
Moody Flat Book .....