

KANSAS

Form 51-5M-7-40-Palace

Ellis

Section 17 Township 11 Range 17-W

Well No. #1 Hadley "D"

Company Champlin Refining


Bemis Pool

NORTH

WEST

EAST

SOUTH

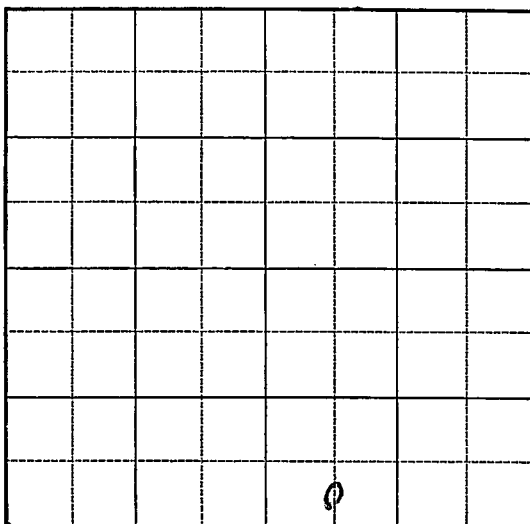


KANSAS

Ellis

Sec. 17 Twp. 11 R. 17WWell No. #1 Hadley "D" FarmChamplin Refining Company
(Bemis Pool) Ft. from N. Line330 Ft. from S. Line Ft. from E. Line660 Ft. from W. Line

Elev. 1871

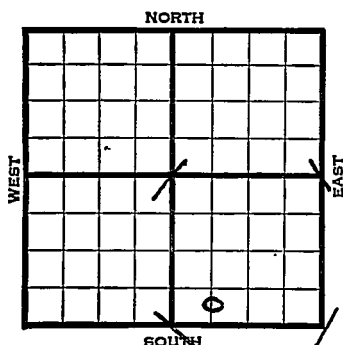

1940

REPORT

8/28

Rotary

9/5

10" - 137' WOC.

9/12

Anhy 1100' Drlg. 3140'

9/19

Arb. 3390' 7" - 3391'

T.D. 3400' 2850' oil 2½ hours.

9/25

Arb. 3390'

7" - 3391'

T.D. 3400'

Echometer potential 14,500 bbls.

Maximum 3000 bbls.

COMPLETED

Map No. _____ Sec. 17 Twp. 11 R. 17W

Well No. 1 Hadley

Champlin Refining Company

Contractor

FIRST REPORT
C S L SW SE

SECTION PLAT


_____ Ft. from N. Line

330 Ft. from S. Line

_____ Ft. from E. Line

660 Ft. from W. Line

BEMIS POOL

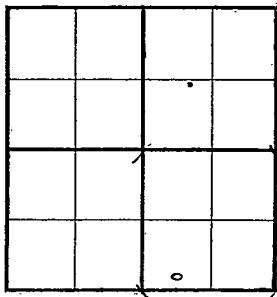

Location _____

Rig up _____

Drilling and Remarks:

Rotary

RECORD

Cased _____ in., _____ ft.

Sand _____

Gas _____

Oil _____

Total Depth _____

PRODUCTION

1st 24 hrs. Nat. _____

1st 24 hrs. after shot _____

Gas _____ Cu. Ft.

Dry Hole _____

Abandoned _____

Date

AUG 28 1940 19

S. J. LEWIS Scout

Map No. 71 Sec. 17 Twp. 11 R. 17WWell No. 1 Hadley "D"Champlin Refining

Company

CORRECTION

Contractor

SECTION PLAT

C S L SW SE

 Ft. from N. Line330 Ft. from S. Line Ft. from E. Line660 Ft. from W. Line

BEMIS POOL

Location Rig up

Drilling and Remarks:

Reported as

#1 Hadley

RECORD

Cased in., ft.Sand Gas Oil Total Depth

PRODUCTION

1st 24 hrs. Nat. 1st 24 hrs. after shot Gas Cu. Ft.Dry Hole Abandoned

Date

SEP 5 1940 19S. J. LEWIS

Scout

Map No. 71 Sec. 17 Twp. 11 R. 17WWell No. 1 Hadley "D"Champlin Refining

Company

Contractor

COMPLETED

C S L SW SE

 Ft. from N. Line330 Ft. from S. Line Ft. from E. Line660 Ft. from W. Line

BEMIS POOL

SECTION PLAT

Location Rig up

Drilling and Remarks:

*Cr & 3390**7" @ 3391**Echo meter P & Y.**14500**Map 3000***RECORD**Cased in., ft.Sand Gas Oil Total Depth 3400**PRODUCTION**21st 24 hrs. Nat. 1st 24 hrs. after shot Gas Cu. Ft.Dry Hole Abandoned

Date

SEP 25 194019S. J. LEWIS Scout