

# KANSAS


Form 51-5M-7-40-Palace

Ellis

Section 17 Township 11 Range 17-W

Well No. #8 Hadley "D"

Company Champlin Refining

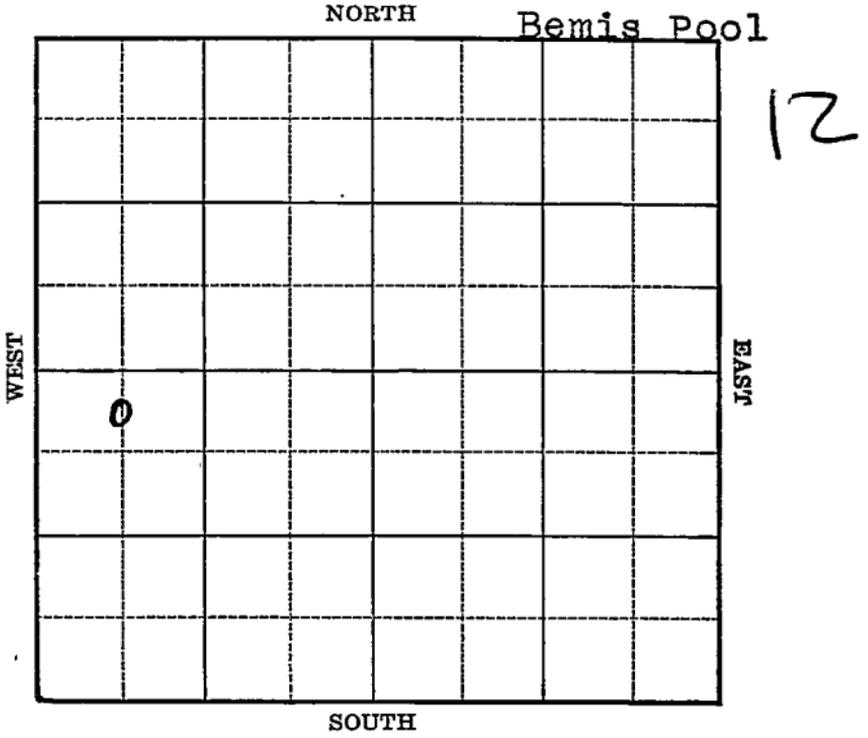





Map No. 71 Sec. 17 Twp. 11 R. 17W

Well No. 8 Hadley "D"

Champlin Refining Company

Contractor

**COMPLETED**

C N L NW SW

330 Ft. from N. Line

\_\_\_\_\_ Ft. from S. Line

\_\_\_\_\_ Ft. from E. Line

660 Ft. from W. Line

BEMIS POOL

**SECTION PLAT**

o			

Location \_\_\_\_\_

Rig up \_\_\_\_\_

Drilling and Remarks:

*Echometer pot.*

*96,924 bbls*

*grav. 33.5*

**RECORD**

Cased \_\_\_\_\_ in., \_\_\_\_\_ ft.

Sand *3370*

Gas \_\_\_\_\_

Oil \_\_\_\_\_

Total Depth *3385*

**PRODUCTION**

1st 24 hrs. Nat. \_\_\_\_\_

1st 24 hrs. after shot \_\_\_\_\_

Gas \_\_\_\_\_ Cu. Ft.

Dry Hole \_\_\_\_\_

Abandoned \_\_\_\_\_

Date

*APR 16 1941* 19

S. J. LEWIS

Scout