


Ellis

Section 17 Township 11 Range 17-W

Well No. #9 Hadley "D"

Company Champlin Refining

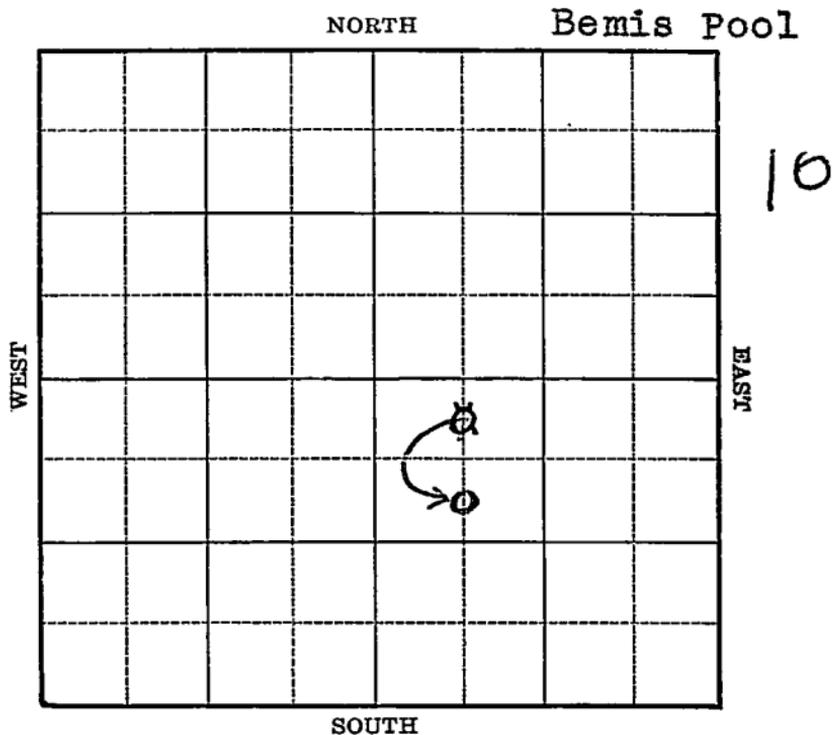

Sec. 17 Twp. 11 R. 17-W

Well No. #9 Hadley "D" Farm

Champlin Refg. Company

(Bemis)


~~330~~ 990 Ft. from N. Line

_____ Ft. from S. Line

_____ Ft. from E. Line

660 Ft. from W. Line

Ele v. 1863

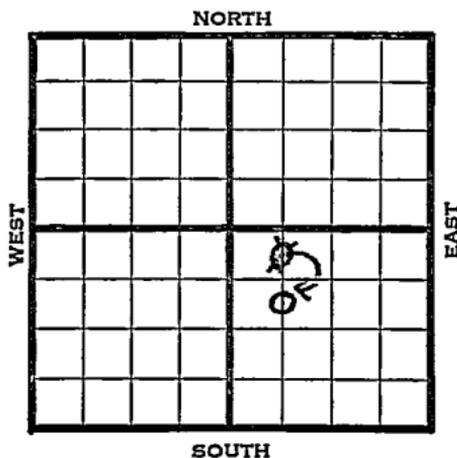

REPORT

1941

3/26

Derrick.

4/3

Surface hole.

4/10

Drlg. 2610'

4/18

8-5/8" & Anhy 1150'

Arb. 3379-93' T.D. 4 1/2" - 3381'

WOC;

4/24

2900' oil. Testing.

4/30

Arb. 3379'

4" - 3381'

T.D. 3393'

Echometer potential 8000 bbls.

Maximum 3000 bbls.

33.5 Gravity

COMPLETED

Map No. 71 Sec. 17 Twp. 11 R. 17W

Well No. 9 Hadley "D"

Champlin Refining Company

FIRST REPORT

Contractor

SECTION PLAT

C N L NW SE

330 Ft. from N. Line

_____ Ft. from S. Line

_____ Ft. from E. Line

660 Ft. from W. Line

		o	

BEMIS POOL

Location _____

Rig up _____

Drilling and Remarks:

Derrick

RECORD

Cased _____ in., _____ ft.

Sand _____

Gas _____

Oil _____

Total Depth _____

PRODUCTION

1st 24 hrs.-Nat. _____

1st 24 hrs. after shot _____

Gas _____ Cu. Ft.

Dry Hole _____

Abandoned _____

Date

MAR 26 1941

S. J. LEWIS Scout

Map No. 71 Sec. 17 Twp. 11 R. 17W

Well No. 9 Hadley "D"

Champlin Refining Company

CORRECTION Contractor

SECTION PLAT

C S L NW SE

990 Ft. from N. Line

_____ Ft. from S. Line

_____ Ft. from E. Line

660 Ft. from W. Line

BEMIS POOL

Location _____

Rig up _____

Drilling and Remarks:

Reported

C N L NW SE

RECORD

Cased _____ in., _____ ft.

Sand _____

Gas _____

Oil _____

Total Depth _____

PRODUCTION

1st 24 hrs. Nat. _____

1st 24 hrs. after shot _____

Gas _____ Cu. Ft.

Dry Hole _____

Abandoned _____

Date

APR 2 1941₁₉

S. J. LEWIS Scout

Map No. 71 Sec. 17 Twp. 11 R. 17W

Well No. 9 Hadley "D"

Champlin Refining Company

COMPLETED Contractor

SECTION PLAT

C S L NW SE

990 Ft. from N. Line

_____ Ft. from S. Line

_____ Ft. from E. Line

660 Ft. from W. Line

BEMIS POOL

Location _____

Rig up _____

Drilling and Remarks:

Cu x 3379
4" C 3381
Ec to P x 5000
Wax 3000

335 Gr

RECORD

Cased _____ in., _____ ft.
 Sand _____
 Gas _____
 Oil _____
 Total Depth 3393

PRODUCTION

1st 24 hrs. Nat. _____
 1st 24 hrs. after shot _____
 Gas _____ Cu. Ft.
 Dry Hole _____
 Abandoned _____

Date

APR 30 1941 19

S. J. LEWIS Scout