

# KANSAS

FORM 51 5M 4-41 PETROL


Ellis

Section 17 Township 11 Range 17-W

Well No. #10 Hadley "D"

Company Champlin Refining

Bemis Pool

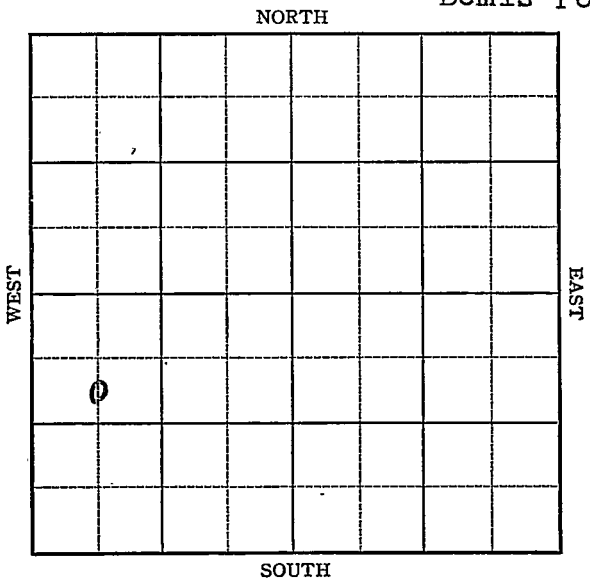

Sec. 17 Twp. 1E R. 17-W

Well No. #10 Hadley "D" Farm

Champlin Refg. Company


(Bemis)

990 Ft. from N. Line

\_\_\_\_\_ Ft. from S. Line

\_\_\_\_\_ Ft. from E. Line

660 Ft. from W. Line

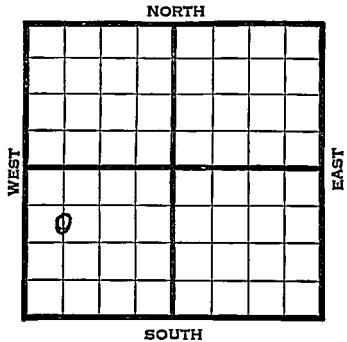

Elev. 1889

1941

REPORT

4/9

Cellar.

4/18

Rigging up.

4/24

Anhy. 1135' 8" - 1137'

Drlg. 2030'

5/1

Lans. 3150' Drlg. 3260'

5/8

Arb. 3397' 4" - 3436' T.D.

120 shots 3398-3416'

2900' oil 1/2 hour.

5/15

" " "

5/21

Arb. 3397'

4" - 3436'

T.D. 3436'

120 shots 3398-3416'

Echometer potential 70,000 bbls.

Maximum 3000 bbls.

33.5 Gravity

COMPLETED

Map No. 71 Sec. 17 Twp. 11 R. 17WWell No. 10 Hadley "D"Champlin Refining Company**FIRST REPORT**

Contractor

C S L NW SW

**SECTION PLAT**990 Ft. from N. Line

\_\_\_\_\_ Ft. from S. Line

\_\_\_\_\_ Ft. from E. Line

660 Ft. from W. Line

BEMIS POOL


Location \_\_\_\_\_

**RECORD**

Cased \_\_\_\_\_ in., \_\_\_\_\_ ft.

Sand \_\_\_\_\_

Gas \_\_\_\_\_

Oil \_\_\_\_\_

Total Depth \_\_\_\_\_

Rig up \_\_\_\_\_

Drilling and Remarks:

Cellar

**PRODUCTION**

1st 24 hrs. Nat. \_\_\_\_\_

1st 24 hrs. after shot \_\_\_\_\_

Gas \_\_\_\_\_ Cu. Ft.

Dry Hole \_\_\_\_\_

Abandoned \_\_\_\_\_

Date

APR 9 1941 19

S. J. LEWIS Scout

Map No. 71 Sec. 17 Twp. 11 R. 17W

Well No. 10 Hadley "D"

Champlin Refining Company

COMPLETED Contractor

**SECTION PLAT**

C S L NW SW

990 Ft. from N. Line

\_\_\_\_\_ Ft. from S. Line

\_\_\_\_\_ Ft. from E. Line

660 Ft. from W. Line


BEMIS POOL

Location \_\_\_\_\_

Rig up \_\_\_\_\_

Drilling and Remarks:

*Cor & 3397*  
*# " @ 3436*  
*120 Blw to 3398-3416*  
*Echd P & 70000*  
*Max 3000*  
*33 1/2 Gr*

**RECORD**

Cased \_\_\_\_\_ in., \_\_\_\_\_ ft.

Sand \_\_\_\_\_

Gas \_\_\_\_\_

Oil \_\_\_\_\_

Total Depth 3436

**PRODUCTION**

1st 24 hrs. Nat. \_\_\_\_\_

1st 24 hrs. after shot \_\_\_\_\_

Gas \_\_\_\_\_ Cu. Ft.

Dry Hole \_\_\_\_\_

Abandoned \_\_\_\_\_

Date

MAY 21 1941

S. J. LEWIS Scout