

KANSAS

Ellis


FORM 51 5M 4-41 PETROL

Section 17 Township 11 Range 17-W

Well No. 11 Hadley "D"

Company Champlin Refining

NORTH Bemis Pool

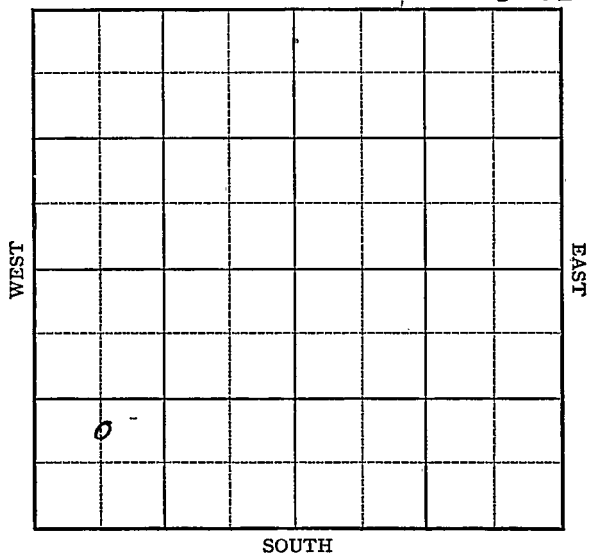

13

Sec. 17 Twp. 1E R. 17-W

Well No. #11 Hadley "D" Farm

Champlin Refg. Company

(Bemis)


_____ Ft. from N. Line

990 Ft. from S. Line

_____ Ft. from E. Line

660 Ft. from W. Line

Elev. 1927

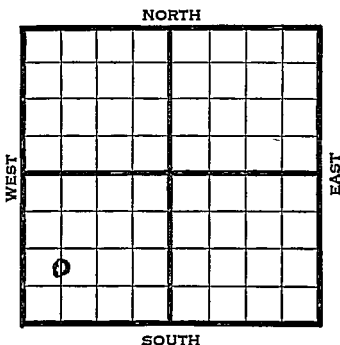

1941	REPORT
4/30	Derrick.
5/8	8" - 1180' Anhy 1174' WOC.
5/15	Drlg. 3315'
5/22	No report.
5/27	Arb. 3681'
	T.D. 3750'
	No shows.
	ABANDONED

Map No. 71 Sec. 17 Twp. 11 R. 17WWell No. 11 Hadley "D"Champlin Refining Company

Contractor

FIRST REPORT

C N L SW SW

 Ft. from N. Line990 Ft. from S. Line Ft. from E. Line660 Ft. from W. Line

BEMIS POOL

SECTION PLAT

o			

Location XRig up

Drilling and Remarks:

Derrick

RECORDCased in., ft.Sand Gas Oil Total Depth **PRODUCTION**1st 24 hrs. Nat. 1st 24 hrs. after shot Gas Cu. Ft.Dry Hole Abandoned

Date

APR 30 1941 19S. J. LEWIS Scout

Map No. 71 Sec. 17 Twp. 11 R. 17WWell No. 11 Hadley "D"Champlin Refining Company

Contractor

~~ABANDONED~~

SECTION PLAT

C N L SW SW

_____ Ft. from N. Line

990 Ft. from S. Line

_____ Ft. from E. Line

660 Ft. from W. Line

BEMIS POOL

0			

Location _____

Rig up _____

Drilling and Remarks:

*CR # 8681**No show*

RECORD

Cased _____ in., _____ ft.

Sand _____

Gas _____

Oil _____

Total Depth 8750

PRODUCTION

1st 24 hrs. Nat. _____

1st 24 hrs. after shot _____

Gas _____ Cu. Ft.

Dry Hole _____

Abandoned _____

Date

MAY 27 1941 19S. J. LEWIS

Scout