

KANSAS

Ellis

Form 51-5M-7-40-Palace


Section 17 Township 11 Range 17-W

Well No. 12 Hadley "D"

Company Champlin Refining

NORTH

Bemis Pool

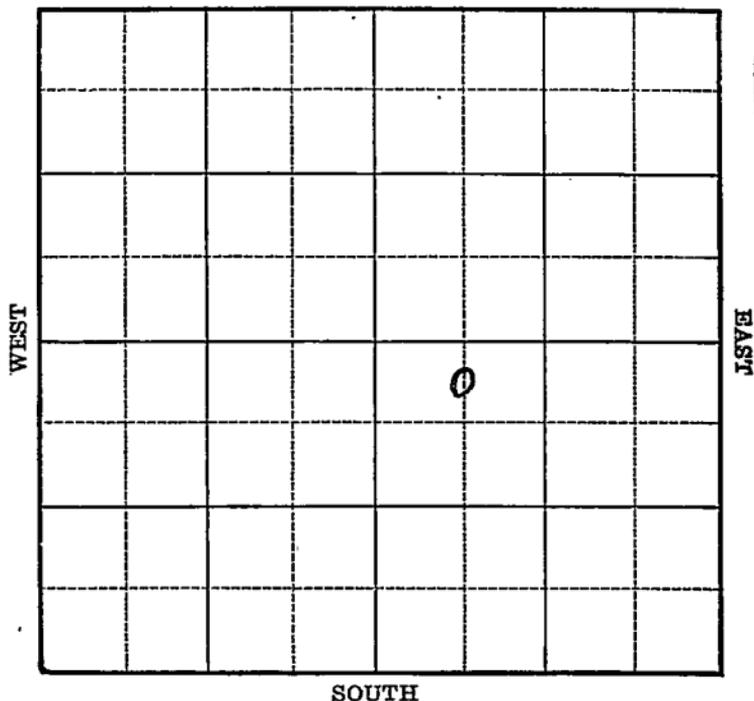

SOUTH

Sec. 17 Twp. 11 R. 17-W

Well No. #12 Hadley "D" Farm

Champlin Refg. Company

(Bemis)


330 Ft. from N. Line

_____ Ft. from S. Line

_____ Ft. from E. Line

660 Ft. from W. Line

Elev. 1818

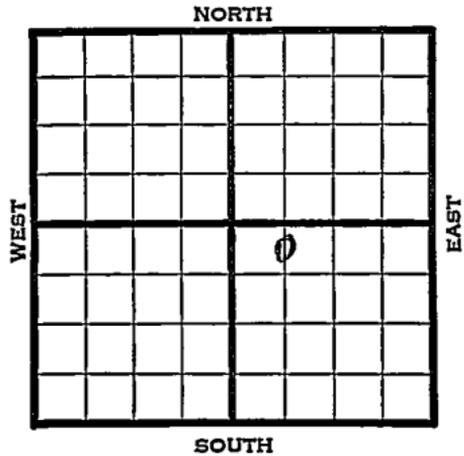

1941	REPORT
5/14	Derrick.
5/22	Anhy 1055' 10" - 1065' WOC.
5/28	Drig. 2500'
6/5	Arb. 3346-53' T.D. 7" - 3346' 2940' oil 1½ hours.
6/12	" " " "
6/18	Arb. 3346'
	7" - 3346'
	T.D. 3353'
	Depth graph potential 6896 bbls.
	Maximum 3000 bbls.
	33.5 Gravity
	COMPLETED

Map No. 71 Sec. 17 Twp. 11 R. 17WWell No. 12 Hadley "D"Champlin Refining CompanyFIRST REPORT Contractor

C N L NW SE

330 Ft. from N. Line

_____ Ft. from S. Line

_____ Ft. from E. Line

660 Ft. from W. Line

BEMIS POOL

SECTION PLAT

		o	

Location _____

Rig up _____

Drilling and Remarks:

Derrick

RECORD

Cased _____ in., _____ ft.

Sand _____

Gas _____

Oil _____

Total Depth _____

PRODUCTION.

1st 24 hrs. Nat. _____

1st 24 hrs. after shot _____

Gas _____ Cu. Ft.

Dry Hole _____

Abandoned _____

Date

MAY 1 1941₁₉

S. J. LEWIS Scout

Map No. 71 Sec. 17 Twp. 11 R. 17W

Well No. 12 Hadley "D"

Champlin Refining Company

Contractor

COMPLETED

SECTION PLAT

C N L NW SE

330 Ft. from N. Line

_____ Ft. from S. Line

_____ Ft. from E. Line

660 Ft. from W. Line

		0	

BEMIS POOL

Location _____

Rig up _____

Drilling and Remarks:

Cor & 3346
7" @ 3346
Depth 286896
May 3000

335-Gr

RECORD

Cased _____ in., _____ ft.

Sand _____

Gas _____

Oil _____

Total Depth 3353

PRODUCTION

1st 24 hrs. Nat _____

1st 24 hrs. after shot _____

Gas _____ Cu. Ft.

Dry Hole _____

Abandoned _____

Date

JUN 1 8 1941

S. J. LEWIS Scout