

KANSAS

Form 51-5M-7-40-Palace


Ellis

Section 17 Township 11 Range 17-W

Well No. #4 Hadley "D"

Company Champlin Refining

NORTH Bemis Pool

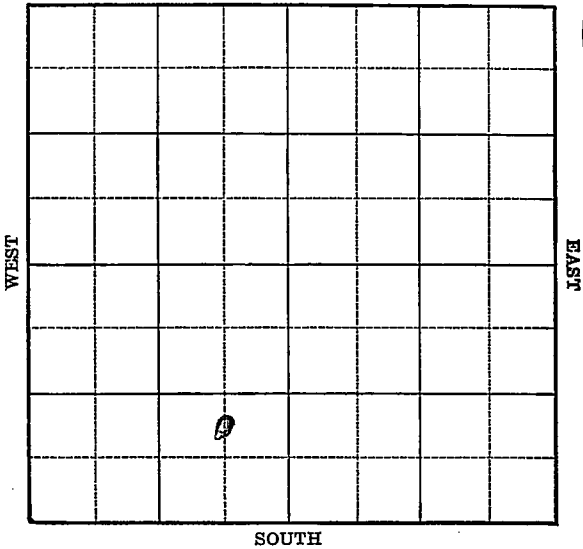

Sec. 17 Twp. 11 R. 17-W

Well No. #4 Hadley "D" Farm

Champlin Refg. Company

(Bemis)


_____ Ft. from N. Line

99.0 Ft. from S. Line

66.0 Ft. from E. Line

_____ Ft. from W. Line

Elev. 1865

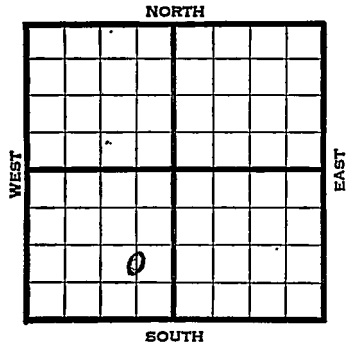

1940	REPORT
10/30	Location
11/7	Anhy 1095' 8" - 1108' WOC.
11/14	Drlg. 3155'
11/21	Arb. 3369' 5" - 3435' T.D.
	RUST.
11/27	60 shots 3379-91' 29.00' oil.
	Testing.
12/4	Arb. 3369'
	5" - 3435'
	T.D. 3435'
	60 shots 3374-91'
	Echometer potential 18,179 bbls
	Maximum 3000 bbls.
	35. Gravity
	COMPLETED

Map No. 71 Sec. 17 Twp. 11 R. 17W

Well No. 4 Hadley "D"

Champlin Refining Company

Contractor

FIRST REPORT

C N L SE SW

 Ft. from N. Line

990 Ft. from S. Line

660 Ft. from E. Line

 Ft. from W. Line

SECTION PLAT

BEMIS POOL

Location X

Rig up

Drilling and Remarks:

RECORD

Cased in., ft.

Sand

Gas

Oil

Total Depth

PRODUCTION

1st 24 hrs. Nat.

1st 24 hrs. after shot

Gas Cu. Ft.

Dry Hole

Abandoned

Date

OCT 30 1940

S. J. LEWIS Scout

Map No. 71 Sec. 17 Twp. 11 R. 17W

Well No. 4 Hadley "D"

Champlin Refining Company

Contractor

COMPLETED

C N L SE SW

 Ft. from N. Line

990 Ft. from S. Line

660 Ft. from E. Line

 Ft. from W. Line

SECTION PLAT

BEMIS POOL

Location

Rig up

Drilling and Remarks:

Cu & 3369
5" @ 3435.
60 Bl. to 3374-9k
Ech. P. & 18179
May 3000
35! Gr.

RECORD

Cased in., ft.

Sand

Gas

Oil

Total Depth 3435

PRODUCTION

1st 24 hrs. Nat.

1st 24 hrs. after shot

Gas Cu. Ft.

Dry Hole

Abandoned

Date

DEC 4 1940 19

S. J. LEWIS Scout