


Section 17 Township 1E Range 17-W

Well No. #6 Hadley "D"

Company Champlin Refg.

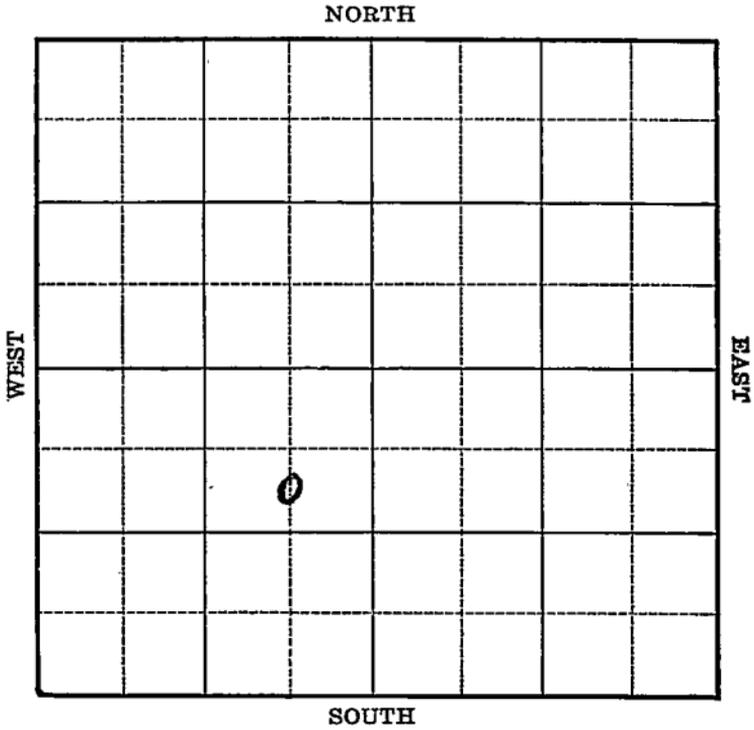

Sec. 17 Twp. 11 R. 17-W

Well No. #6 Hadley "D" Farm

Champlin Refg. Company

(Bemis)


990 Ft. from N. Line

\_\_\_\_\_ Ft. from S. Line

660 Ft. from E. Line

\_\_\_\_\_ Ft. from W. Line

Elev. 1893

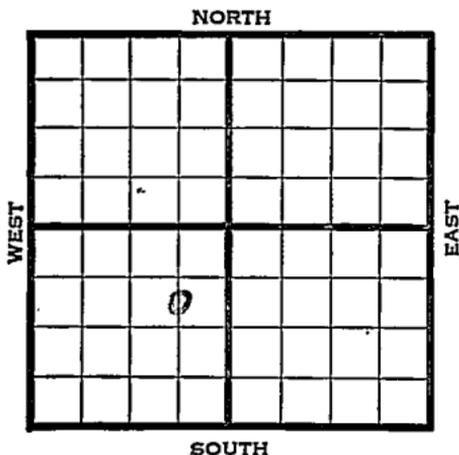

1941	REPORT
2/12	Cellar.
2/20	Rotary.
2/26	Anhy 1143' 8" - 1153'
	Drlg. 2305'
3/6	Arb. 3396' T.D. 3440'
	4" - 3440' RUST.
3/12	Arb. 3396'
	4" - 3440'
	T.D. 3440'
	Drilled plug to 3425'
	36 shots 3398-3412'
	Echometer potential 12,875 bbls.
	Maximum 3000 bbls.
	33.5 Gravity
	COMPLETED

Map No. 71 Sec. 17 Twp. 11 R. 17W

Well No. 6 Hadley "D"

Champlin Refining Company

Contractor

*WORTH LEWIS*

C S L NE SW

**SECTION PLAT**

990 Ft. from N. Line

\_\_\_\_\_ Ft. from S. Line

660 Ft. from E. Line

\_\_\_\_\_ Ft. from W. Line


BEMIS POOL

Location \_\_\_\_\_

Rig up \_\_\_\_\_

Drilling and Remarks:

Cellar

**RECORD**

Cased \_\_\_\_\_ in., \_\_\_\_\_ ft.

Sand \_\_\_\_\_

Gas \_\_\_\_\_

Oil \_\_\_\_\_

Total Depth \_\_\_\_\_

**PRODUCTION**

1st 24 hrs. Nat. \_\_\_\_\_

1st 24 hrs. after shot \_\_\_\_\_

Gas \_\_\_\_\_ Cu. Ft.

Dry Hole \_\_\_\_\_

Abandoned \_\_\_\_\_

Date

FEB 12 1941

S. J LEWIS Scout

Map No. 71 Sec. 17 Twp. 11 R. 17W

Well No. 6 Hadley "D"

Champlin Refining Company

Contractor

**COMPLETED**

C S L N E S W

990 Ft. from N. Line

\_\_\_\_\_ Ft. from S. Line

660 Ft. from E. Line

\_\_\_\_\_ Ft. from W. Line

**SECTION PLAT**


BEMIS POOL

Location \_\_\_\_\_

Rig up \_\_\_\_\_

Drilling and Remarks:

*Ar & 3396*  
*4" C 3440*  
*Trillsch Plug & 3425.*  
*36 Blks to 3098-3412*  
*Echo A & 12875*  
*Max 3000*  
*33.5 Gr*

**RECORD**

Cased \_\_\_\_\_ in., \_\_\_\_\_ ft.

Sand \_\_\_\_\_

Gas \_\_\_\_\_

Oil \_\_\_\_\_

Total Depth 3440

**PRODUCTION**

1st 24 hrs. Nat. \_\_\_\_\_

1st 24 hrs. after shot \_\_\_\_\_

Gas \_\_\_\_\_ Cu. Ft.

Dry Hole \_\_\_\_\_

Abandoned \_\_\_\_\_

Date

MAR 12 1941 19

S. I. LEWIS Scout