

# KANSAS

Form 51-5M-7-40-Palace

Ellis


Section 17 Township 11 Range 17-W

Well No. #7 Hadley "D"

Company Champlin Refining

NORTH

Bemis Pool

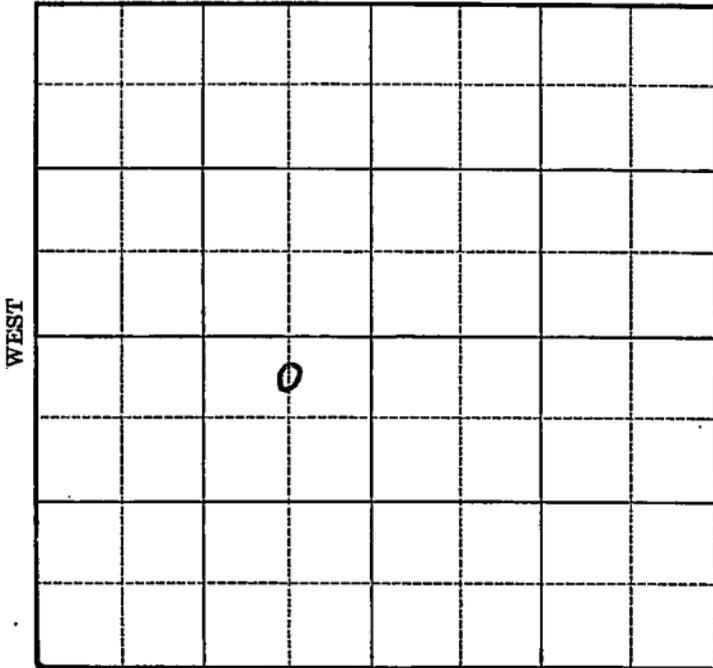

SOUTH

11

Sec. 17 Twp. 11 R. 17-W

Well No. #7 Hadley "D" Farm

Champlin Refg. Company


(Bemis)

330 Ft. from N. Line

Ft. from S. Line

660 Ft. from E. Line

Ft. from W. Line

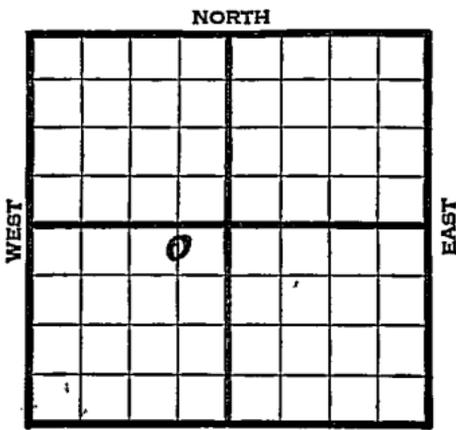

Elev. 1885

1941	REPORT
2/5	Rotary.
3/13	Anhy 1130' 8" - 1150'
	Drlg. 2835'
3/20	Lans. 3070' Run esg.
3/26	Arb. 3394'
	5" - 3430'
	T.D. 3430'
	60 shots 3397-3411'
	Echometer potential 25,650 bbls.
	Maximum 3000 bbls.
	33.5 Gravity
	<b>COMPLETED</b>

Map No. 71 Sec. 17 Twp. 11 R. 17W

Well No. 7 Hadley "D"

Champlin Refining Company

FIRST REPORT Contractor

**SECTION PLAT**

C N L NE SW

330 Ft. from N. Line

\_\_\_\_\_ Ft. from S. Line

660 Ft. from E. Line

\_\_\_\_\_ Ft. from W. Line

	o		

Bemis Pool

Location \_\_\_\_\_

Rig up \_\_\_\_\_

Drilling and Remarks:

Rotary

**RECORD**

Cased \_\_\_\_\_ in., \_\_\_\_\_ ft.

Sand \_\_\_\_\_

Gas \_\_\_\_\_

Oil \_\_\_\_\_

Total Depth \_\_\_\_\_

**PRODUCTION**

1st 24 hrs. Nat. \_\_\_\_\_

1st 24 hrs. after shot \_\_\_\_\_

Gas \_\_\_\_\_ Cu. Ft.

Dry Hole \_\_\_\_\_

Abandoned \_\_\_\_\_

Date

MAR 5 1941 19

S. J. LEWIS Scout

Map No. 71 Sec. 17 Twp. 11 R. 17W

Well No. 7 Hadley "D"

Champlin Refining Company

COMPLETED Contractor

SECTION PLAT

C N L NE SW

	o		

330 Ft. from N. Line

\_\_\_\_\_ Ft. from S. Line

660 Ft. from E. Line

\_\_\_\_\_ Ft. from W. Line

BEMIS POOL

Location \_\_\_\_\_

Rig up \_\_\_\_\_

Drilling and Remarks:

*Art 3394*

*5" C 3430*

*60 Bk to 3397-3411*

*Echo Rd. 25650*

*Map 3000*

*335 ft*

RECORD

Cased \_\_\_\_\_ in., \_\_\_\_\_ ft.

Sand \_\_\_\_\_

Gas \_\_\_\_\_

Oil \_\_\_\_\_

Total Depth 3430

PRODUCTION

1st 24 hrs. Nat. \_\_\_\_\_

1st 24 hrs. after shot \_\_\_\_\_

Gas \_\_\_\_\_ Cu. Ft.

Dry Hole \_\_\_\_\_

Abandoned \_\_\_\_\_

Date

MAR 26 1941 19

S. J. LEWIS Scout