


Section 17 Township 11 Range 23 W

Well No. # 1 Kline

Company Peel Hardman

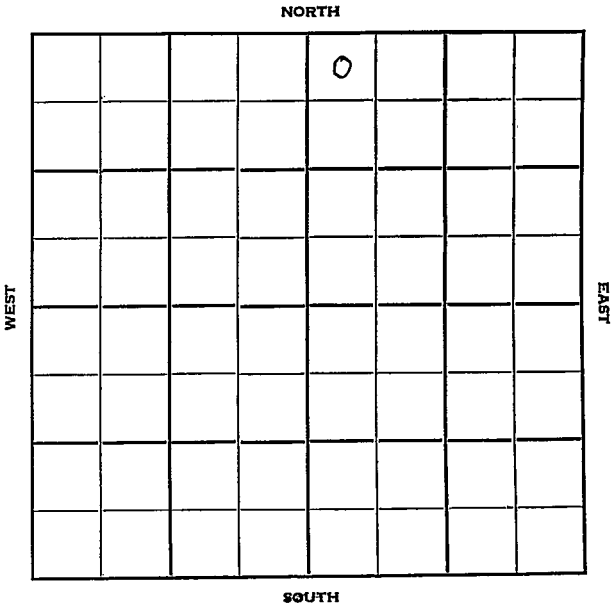

Trego
11

KANSAS

Sec. 17 Twp. _____ R. 23W

Well No. #1 Kline Farm _____

Peel Hardman Company _____

Contractor _____

Wildcat


330' Ft. from N. Line

_____ Ft. from S. Line

_____ Ft. from E. Line

330' Ft. from W. Line

NW NW NE

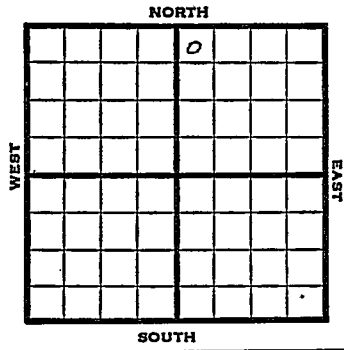

1951 Elev. 2272' REPORT

6/27 Location

8/15 Spud 7-17-51
 D & A TD 4290' 8" @ 158
 Heeb 3613' Lans. 3648' B KC 3996'
 Arb. 4233' TD 4290' D & A

ABANDONED

County Trego State Kansas

Sec. 17 (^{Blk.}Twp.) 11 (^{Sur.}Rge.) 23W Map No.

Operator Peel - Hardman

Well No. 1 Farm Kline

Elev. 2272 Location NW NW NE

330 Ft. From N Line NE

330 Ft. From W Line Quarter

Ist. Report

Completion AUG 15 1951

Remarks Wildcat

Spudding Date 7-17-51

Drig. Data D & A TD 4290

8" @ 158 Heeb. 3613 Lams. 3648

B KC 3996 Arb. 4233 TD 4290

D & A

J. E. TYRA