

WICHITA, BRANCH
S. 7 T. 11S R. 17 ^{XBC} W

Loc. 80' W N/2 SW NW
County Ellis Co., Kansas

KANSAS DRILLERS LOG

API No. 15 — 051-22 — 098
County Number

Operator
Liberty Enterprises, Inc.

Address
308 West Mill Plainville, Kansas 67663


Well No. Lease Name
SWDW #1 Collins Henderson

Footage Location
330 N Line 580 W Line
feet from (N) (S) line feet from (E) (W) line

Principal Contractor Geologist
Pioneer Drilling Company, Inc. Bob Pfannenstiel

Spud Date Total Depth P.B.T.D.
9-16-80 3767

Date Completed Oil Purchaser
9-26-80 SWDW

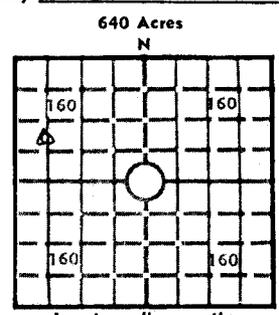

Elev.: Gr. 1886
DF 1889 KB 1891

CASING RECORD

Report of all strings set — surface, intermediate, production, etc.

Purpose of string	Size hole drilled	Size casing set (in O.D.)	Weight lbs/ft.	Setting depth	Type cement	Sacks	Type and percent additives
Surface	12 1/4"	8 5/8"	28#	1218.12	60-40 poz common	275 125	2% gel 3% cc 2% gel 3% cc
Production	7 7/8"	5 1/2"	14#	3595.44	60-40 poz common	100 50	10% salt 20 gal latex

LINER RECORD

PERFORATION RECORD

Top, ft.	Bottom, ft.	Sacks cement	Shots per ft.	Size & type	Depth interval

TUBING RECORD

Size	Setting depth	Packer set at
2 1/2" fiberglass	2300'	2300'

ACID, FRACTURE, SHOT, CEMENT SQUEEZE RECORD

Amount and kind of material used	Depth interval treated

INITIAL PRODUCTION

Date of first production	Producing method (flowing, pumping, gas lift, etc.)
RATE OF PRODUCTION PER 24 HOURS	Oil bbls. Gas bbls. Water bbls. Gas-oil ratio CFPB
Disposition of gas (vented, used on lease or sold)	Producing interval (s)

INSTRUCTIONS: As provided in KCC Rule 82-2-125, within 90 days after completion of a well, one completed copy of this Drillers Log shall be transmitted to the State Geological Survey of Kansas, 4150 Monroe Street, Wichita, Kansas 67209. Copies of this form are available from the Conservation Division, State Corporation Commission, 3830 So. Meridian (P.O. Box 17027), Wichita, Kansas 66217. Phone AC 316-522-2206. If confidential custody is desired, please note Rule 82-2-125. Drillers Logs will be on open file in the Oil and Gas Division, State Geological Survey of Kansas, Lawrence, Kansas 66044.

Operator

DESIGNATE TYPE OF COMP.: OIL, GAS, DRY HOLE, SWDW, ETC.:

Liberty Enterprises, Inc

Well No.

SWDW #1

Lease Name

Collins Henderson

SWDW

S 7 T11S R 17 ^{EX} W

WELL LOG

Show all important zones of porosity and contents thereof; cored intervals, and all drill-stem tests, including depth interval tested, cushion used, time tool open, flowing and shut-in pressures, and recoveries.

SHOW GEOLOGICAL MARKERS, LOGS RUN, OR OTHER DESCRIPTIVE INFORMATION.

FORMATION DESCRIPTION, CONTENTS, ETC.	TOP	BOTTOM	NAME	DEPTH

USE ADDITIONAL SHEETS, IF NECESSARY, TO COMPLETE WELL RECORD.

Date Received

Charles G. Coméau
Geologist

Signature

Title

1/8/81

Date