

**KANSAS GEOLOGICAL SOCIETY**  
**KANSAS WELL LOG BUREAU - KANSAS WELL SAMPLE BUREAU**  
**KANSAS GEOLOGICAL SOCIETY BUILDING**  
**508 EAST MURDOCK - WICHITA, KANSAS**

COMPANY **ABERCROMBIE DRILLING**

SEC. 12 T. 11 R. 17W

FARM Simpson NO. 1

LOC. NW NW SE

TOTAL DEPTH 3328'

COUNTY **ELLIS**


COMM. 1-19-67

COMP. 1-28-67

SHOT OR TREATED

CONTRACTOR **Abercrombie Drilling**

ISSUED 3-4-67

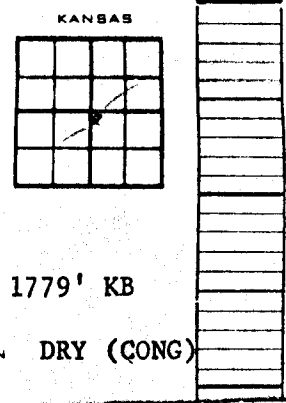

CASING

20	10	
15	7	"/964' cem w/ 275 sx
12	6	
13	5	

ELEVATION 1779' KB

PRODUCTION **DRY (QONG)**

FIGURES INDICATE BOTTOM OF FORMATIONS

0	115	Sand
115	690	Shale, Sand & Shells
690	960	Shells, Shale & Red Beds
960	1002	Anhydrite
1002	1540	Shells, Shale & Lime
1540	1835	Shale with Lime Streaks
1835	2010	Lime
2010	2230	Shale & Lime
2230	2420	Lime & Shale
2420	2645	Shale & Lime
2645	2760	Shale
2760	2865	Lime & Shale
2865	2977	Shale & Lime
2977	3037	Lime & Shale
3037	3135	Shale & Lime
3135	3197	Lime & Shale
3197	3211	Shale & Lime
3211	3215	Lime
3215	3275	Lime & Shale
3275	3328	Chert & Lime
	3328	Total Depth

7" Surface Casing was set at 964 feet with 275 sacks of cement.

Dry and Abandoned

FORMATION TOPS:

ELEVATION:

Heebner	2926	(-1147)	1779 K.B.
Toronto	2947	(-1168)	1778 D.F.
Lansing	2969	(-1190)	1772 G.L.
B/K.C.	3210	(-1431)	
Conglomerate	3237	(-1458)	
T.D.	3328	(-1549)	

STATE OF KANSAS )  
 )  
 COUNTY OF SEDGWICK )      SS