


26-11-17W

WELL RECORD

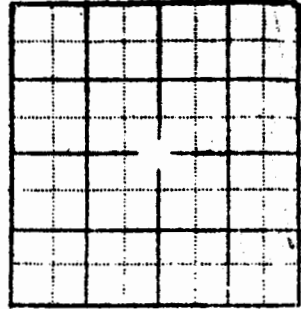

Company Cities Service Oil Co. No. 2 Farm McCord
 Location 1040' E., 1090' S., N/4 Cor. Sec. 26 T. 11 R. 17-W
 Elevation 2066 County Ellis State Kansas
 Drig. Comm: Apr. 15, 1939
 Date Completed May 7, 1939 Initial Production 710 oil, 4% water
 Contractor: J. E. Mabee Company Acidized 2000 gallons

Total Depth 3563'

CASING RECORD:

8-5/8" 1111' con. 300 reg., 25 Oil-Max & 7 Aquagel
 8-1/8" 3535' con. 100 cement & 18 Aquagel

FORMATION RECORD:

surface 30
 surface rock 45
 lost circulation
 shale & shells 463
 sand 540
 shale 625
 sand iron & shells 745
 shale & shells 780
 sand 897
 shale & shells 1070
 red bed shale 1086
 shale & shells 1111
 red bed 1190
 shale & shells 1255
 anhydrite 1285
 shale & shells 1580
 salt & shale 1896
 lime broken 1984
 lime & shale 2046
 broken lime 2090
 lime 2116
 lime broken 2155
 lime 2308
 lime broken 2320
 lime & shale 2421
 shale 2451
 shale & lime 2513
 shale & shells 2570
 lime & shale 2713
 shale & shells 2917
 shale 2952
 shale & lime 3000
 lime 3244
 lime & shale 3257
 lime broken 3270
 lime 3286
 broken lime 3385

MAY 03 1939

lime 3510
 lime broken 3520
 lime 3540
 top Arbuckle 3538
 T. D. rotary 3540
 8-1/2" O. D. 3539
 dolomite
 T. D. rotary 3540 = 3535 SIM
 top Arbuckle corr. 3533
 dolomite 3563 T. D.

Top Arbuckle 3533
 Penetration 30
 Total Depth 3563

Pay 3555-62

FILLUP: 250' 8-3/4 hrs.
 1300' 18-1/2 hrs.

SYFO: 500' 1/2°
 1000' 0°
 1500' 0°
 2000' 0°
 2500' 0°
 3000' 0°

Rotary 3535
 Cable Tools 3563

RECEIVED
 STATE CORPORATION COMMISSION

APR 29 1991

CONSERVATION DIVISION
 Wichita, Kansas