


Section 18 Township 11 Range 16-W

Well Number #1 Romine

Company Lario

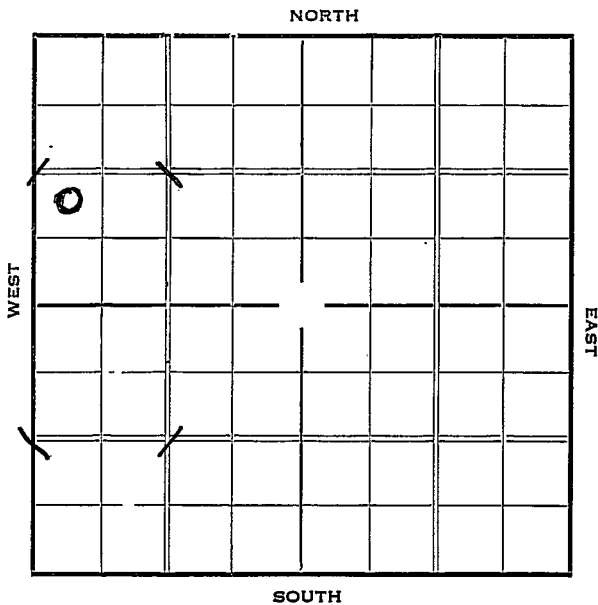

Sec. 18 Twp. 11 R. 16-W

Well No. #1 Romine Farm


Lario Company

 Ft. from N. Line

990 Ft. from S. Line

 Ft. from E. Line

330 Ft. from W. Line

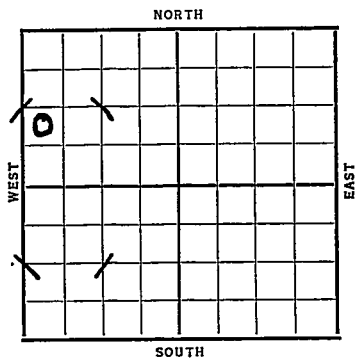

Date	REPORT
1937	
6/30	Location
7/9	Cellar
7/16	R U R
7/23	15" @ 850'. Drlg. 910'.
7/30	Anhy 985'. Drlg. 2743'.
8/6	Sil. 3312'. T.D. 3315'. Sat. core. Rng. 7".
8/13	7" @ 3311'. 2900' oil 1 hour. Drl g. 3316'.
8/18	7" @ 3311'. Sil. 3312'. T.D. 3317'.
	Pot. 1668 lbs.
	COMPLETED

Ellis KANSAS

Map No. _____ Sec. 18 Twp. 11 R. 16 WWell No. 1 - RomineLario _____ Company_____
Contractor

FIRST REPORT

SECTION PLAT

10	X		
X	X		

_____ Ft. from N. Line

990 Ft. from S. Line

_____ Ft. from E. Line

330 Ft. from W. LineLocation

Rig up _____

Drilling and Remarks:

RECORD

Cased _____ in., _____ ft.

Sand _____

Gas _____

Oil _____

Total Depth _____

PRODUCTION

1st 24 hrs. Nat. _____

1st 24 hrs. after shot _____

Gas _____ Cu. Ft.

Dry Hole _____

Abandoned _____

Date

JUN 30 1937 19 _____ H. D. Hatfield Scout

Ellis KANSAS

Map No. _____ Sec. 18 Twp. 11 R. 16^w

Well No. 1 - Romine

Lario Company

Contractor

COMPLETED

SECTION PLAT

_____ Ft. from N. Line

990 Ft. from S. Line

_____ Ft. from E. Line

330 Ft. from W. Line

0			

Location _____

Rig up _____

Drilling and Remarks:

Pat - 1668

RECORD

Cased 7 in., 3311 ft.

Sand 511 3312

Gas _____

Oil _____

Total Depth 3317

PRODUCTION

1st 24 hrs. Nat. _____

1st 24 hrs. after shot _____

Gas _____ Cu. Ft.

Dry Hole _____

Abandoned _____

Date

AUG 18 1937 19

H. D. Hatfield Scout