


Section 18 Township 11 Range 16-W

Well No. 3 - Romine

Company Lario Oil

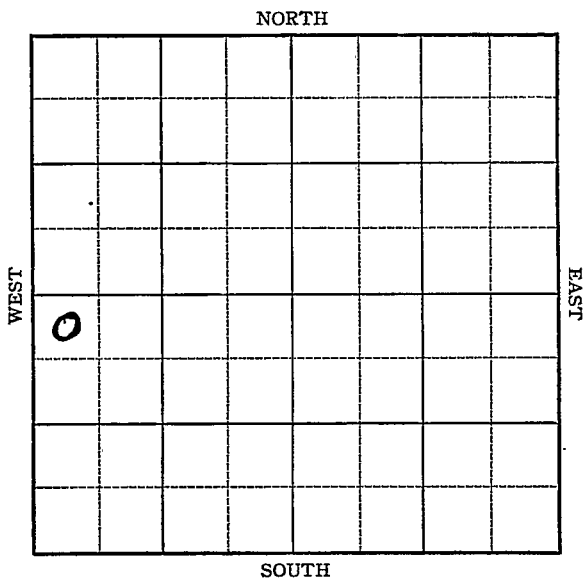

Sec. 18 Twp. 11 R. 16-W

Well No. #3-Romine Farm

Lario Oil Company


330 Ft. from N. Line

\_\_\_\_\_ Ft. from S. Line

\_\_\_\_\_ Ft. from E. Line

330 Ft. from W. Line

Elev. 1827

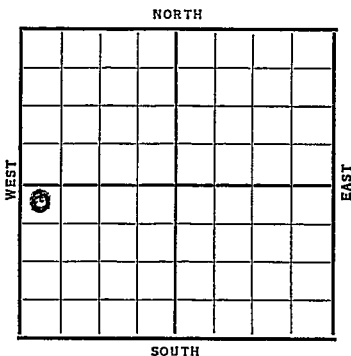

Date	REPORT
1937	
9/8	Location
9/17	R. R.
9/24	"
10/2	R U R
10/8	Anhy 1017'. Rng. 10 <sup>ft</sup> .
10/15	Drlg. 2010'.
10/22	Drlg. 3100'.
10/29	Sil. & 7" @ 3339' T.D. RUST.
	No shows.
11/5	T.D. 3347'. 2800' oil.
11/10	7" @ 3339'.
	Sil. 3339'.
	T.D. 3347'.
	Potential 2173 bbls. Nat.
	<b>COMPLETED</b>

Map No. \_\_\_\_\_ Sec. 18 Twp. 11 R. 16W

Well No. 3 - Romine  
Lario oil Company \_\_\_\_\_

Contractor \_\_\_\_\_

**FIRST REPORT**

**SECTION PLAT**

330 Ft. from N. Line  
\_\_\_\_\_ Ft. from S. Line  
\_\_\_\_\_ Ft. from E. Line  
330 Ft. from W. Line

0			

Location  \_\_\_\_\_

Rig up \_\_\_\_\_

Drilling and Remarks: \_\_\_\_\_

**RECORD**

Cased \_\_\_\_\_ in., \_\_\_\_\_ ft.

Sand \_\_\_\_\_

Gas \_\_\_\_\_

Oil \_\_\_\_\_

Total Depth \_\_\_\_\_

**PRODUCTION**

1st 24 hrs. Nat. \_\_\_\_\_

1st 24 hrs. after shot \_\_\_\_\_

Gas \_\_\_\_\_ Cu. Ft.

Dry Hole \_\_\_\_\_

Abandoned \_\_\_\_\_

Date

SEP 8 1937

**H. D. Hatfield**

Scout

Ellis **KANSAS**Map No. 71 Sec. 18 Twp. 11 R. 16WWell No. 3 RomineLario

Company

Contractor

**COMPLETED**

NW SW

330 Ft. from N. Line

\_\_\_\_\_ Ft. from S. Line

\_\_\_\_\_ Ft. from E. Line

330 Ft. from W. Line**SECTION PLAT**

0			

Location \_\_\_\_\_

Rig up \_\_\_\_\_

Drilling and Remarks:

POT-2173  
NAT.

**RECORD**Cased 7 in., 3339 ft.Sand 511 3339

Gas \_\_\_\_\_

Oil \_\_\_\_\_

Total Depth 3347**PRODUCTION**

1st 24 hrs. Nat. \_\_\_\_\_

1st 24 hrs. after shot \_\_\_\_\_

Gas \_\_\_\_\_ Cu. Ft.

Dry Hole \_\_\_\_\_

Abandoned \_\_\_\_\_

Date

NOV 10 1937 19H. D. Hatfield Scout