


Section 18 Township 11 Range 16-W

Well No. 4- Romine

Company Rupublic Nat. gas

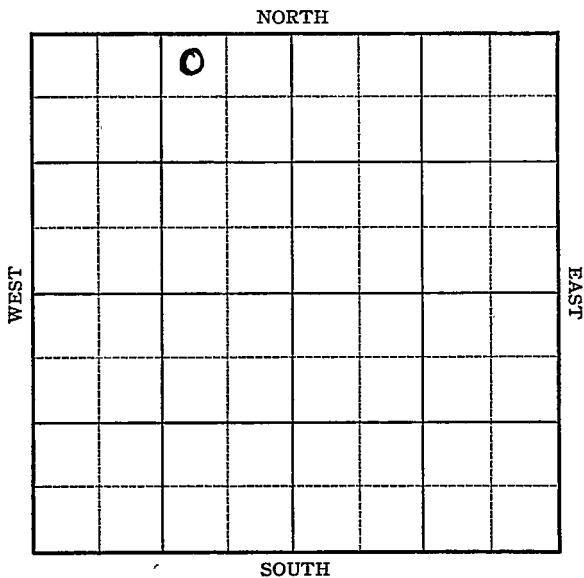

Sec. 18 Twp. 11 R. 16-W

Well No. #4 Romine Farm

Republic Nat. Gas Company


330 Ft. from N. Line

_____ Ft. from S. Line

990 Ft. from E. Line

_____ Ft. from W. Line

Elev. 1783

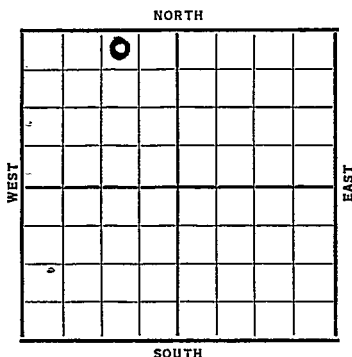

Date

REPORT

1937

8/18

B. R. R.

8/28

R U R

9/3

"

9/10

15" @ 100'. Drlg. 990'.

9/17

Drlg. 2100'.

9/24

Drlg. 2970'.

10/2

Sil. 3307' T.D. No shows.

Running 7".

10/8

7" @ 3307'. T.D. 3314'.

1200' oil 8 hrs. 1000 acid.

10/15

T.D. 3321'. 3000' oil.

Pumped 339 B.O. 4 hrs.

Natural. Acidizing.

OVER

1937

10/20 15" @ 100'.

7" @ 3307'.

Sil. 3307'.

T.D. 3324'.

2000 acid.

Potential 2498 bbls.

COMPLETED

Ellis **KANSAS**

Map No. _____ Sec. 18 Twp. 11 R. 16^w

Well No. 4 Romine

Republic Nat Gas Company

Contractor

FIRST REPORT

330 Ft. from N. Line

_____ Ft. from S. Line

990 Ft. from E. Line

_____ Ft. from W. Line

SECTION PLAT

	0		
			.

Location _____

Rig up _____

Drilling and Remarks:

BRR

RECORD

Cased _____ in., _____ ft.

Sand _____

Gas _____

Oil _____

Total Depth _____

PRODUCTION

1st 24 hrs. Nat. _____

1st 24 hrs. after shot _____

Gas _____ Cu. Ft.

Dry Hole _____

Abandoned _____

Date

AUG 18 1937 19

H. D. Hatfield

Scout

Map No. _____ Sec. 18 Twp. 11 R. 16WWell No. 4 RomineRepublic Nat Gas Company

Contractor _____

COMPLETED

SECTION PLAT

NW NE NW
330 Ft. from N. Line

_____ Ft. from S. Line

990 Ft. from E. Line

_____ Ft. from W. Line

	0		

Location _____

Rig up _____

Drilling and Remarks:

2000 Acid.POT- 2498

15" - 100
RECORD
Cased 7 in., 3307 ft.
Sand sil 3307
Gas _____
Oil _____
Total Depth 3324

PRODUCTION

1st 24 hrs. Nat. _____

1st 24 hrs. after shot _____

Gas _____ Cu. Ft.

Dry Hole _____

Abandoned _____

Date

OCT 20 1937 19H. D. Hatfield Scout