


Ellis

Section 18 Township 11 Range 16-W

Well No. 5 Romine

Company Lario

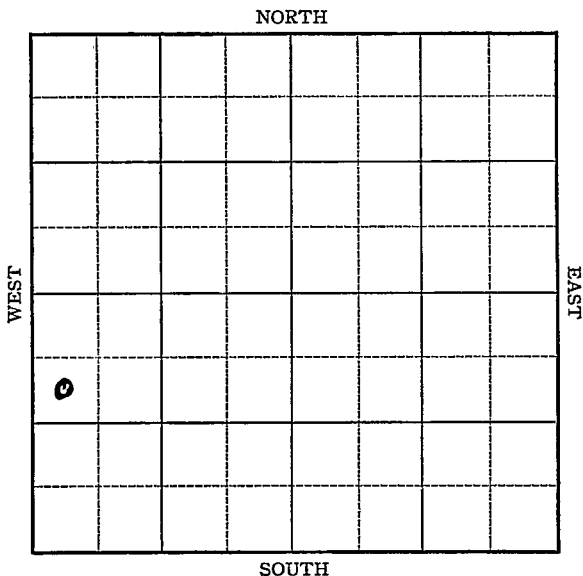

Sec. 18 Twp. 11 R. 16-W

Well No. #5 Romine Farm _____
Lario Company _____


990 Ft. from N. Line

_____ Ft. from S. Line

_____ Ft. from E. Line

330 Ft. from W. Line

Elev. 1873

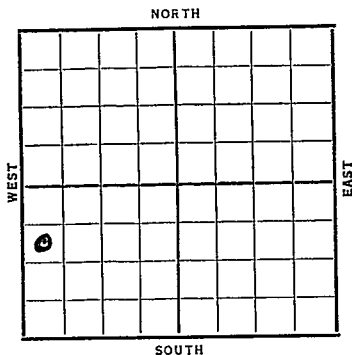

Date	REPORT
1937	
12/1	Cellar.
12/10	B. R. R.
12/17	Drlg. 300'.
12/24	Drlg. 2150'.
12/31	Drlg. 3015'.
1938	
1/7	Arb. 7" @ 3387'.
	T.D. 3390'. Sat. core. RUST.
1/12	7" @ 3387'.
	Arb. 3387'.
	T.D. 3391'.
	Potential 2677 bbls., Nat.
	COMPLETED

Map No. 7/ Sec. 18 Twp. 11 R. 16WWell No. 5 RomineLario Company

Contractor

FIRST REPORT

SW NW SW

990 Ft. from N. Line

_____ Ft. from S. Line

_____ Ft. from E. Line

330 Ft. from W. Line

SECTION PLAT

Location _____

Rig up _____

Drilling and Remarks:

Cellar

RECORD

Cased _____ in., _____ ft.

Sand _____

Gas _____

Oil _____

Total Depth _____

PRODUCTION

1st 24 hrs. Nat. _____

1st 24 hrs. after shot _____

Gas _____ Cu. Ft.

Dry Hole _____

Abandoned _____

Date

DEC 17 1937

19

H. D. Hatfield Scout

Ellis **KANSAS**

Map No. 71 Sec. 18 Twp. 11 R. 16W

Well No. 5 Romine

Tario Company

Contractor

COMPLETED

SECTION PLAT

SW NW SW
990 Ft. from N. Line
 _____ Ft. from S. Line
 _____ Ft. from E. Line
330 Ft. from W. Line

0	.		

Location _____

Rig up _____

Drilling and Remarks:

POT-2677
NAT.

RECORD

Cased 7 in., 3387 ft.

Sand A-b 3387

Gas _____

Oil _____

Total Depth 3391

PRODUCTION

1st 24 hrs. Nat. _____

1st 24 hrs. after shot _____

Gas _____ Cu. Ft.

Dry Hole _____

Abandoned _____

Date

JAN 12 1938 19

H. D. Hatfield

Scout