

Ellis


Form 51-5M 5-37 Petrol

KANSAS

Section 18 Township 11 Range 16-W


Well No. 5 - Romine

Company Republic Nat. Gas

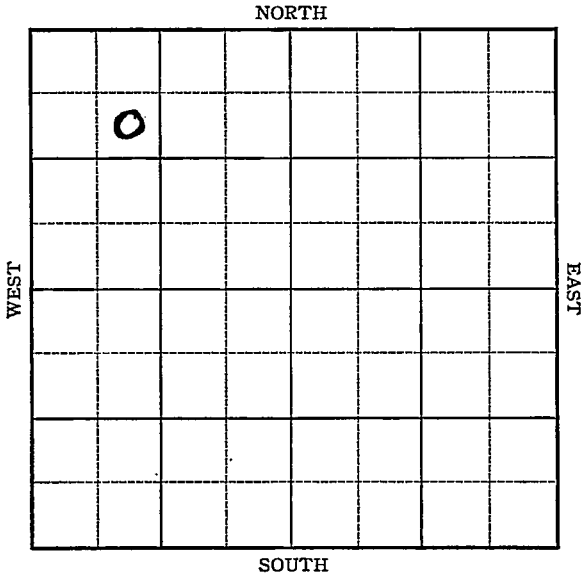

Sec. 18 Twp. 11 R. 16-WWell No. #5 Romine FarmRepublic Nat Gas Company990 Ft. from N. Line       Ft. from S. Line       Ft. from E. Line990 Ft. from W. Line

Elev. 1781

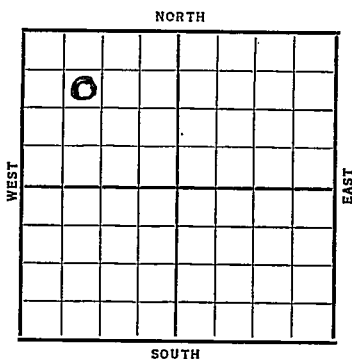

Date

REPORT

1937

9/15

Mat.

9/24

B. R.

10/2

R. R.

10/8

15" @ 94'. Drlg. 385'.

10/15

Anhy 974'. 10" @ 976'.

Drlg. 1430'.

10/22

Drlg. 2433'.

10/29

Drlg. 3127'.

11/5

Sil. <sup>3299</sup> & 7" @ ~~3298~~ <sup>3299</sup>. T.D. 3299'.

No shows. RUST.

11/10

7" @ 3299' (Corrected)

Sil. 3298'.

T.D. 3303'.

1000 acid.

Potential 2690 bbls.

COMPLETED

Ellis KANSAS

Map No. \_\_\_\_\_ Sec. 18 Twp. 11 R. 16 WWell No. 5-RomineRepublic Nat Gas Company

Contractor

## FIRST REPORT

## SECTION PLAT

0			

990 Ft. from N. Line

\_\_\_\_\_ Ft. from S. Line

\_\_\_\_\_ Ft. from E. Line

990 Ft. from W. Line

Location \_\_\_\_\_

Rig up \_\_\_\_\_

Drilling and Remarks:

mat.

## RECORD

Cased \_\_\_\_\_ in., \_\_\_\_\_ ft.

Sand \_\_\_\_\_

Gas \_\_\_\_\_

Oil \_\_\_\_\_

Total Depth \_\_\_\_\_

## PRODUCTION

1st 24 hrs. Nat. \_\_\_\_\_

1st 24 hrs. after shot \_\_\_\_\_

Gas \_\_\_\_\_ Cu. Ft.

Dry Hole \_\_\_\_\_

Abandoned \_\_\_\_\_

Date

SEP 15 1937  
19

H. D. Hatfield Scout

Ellis KANSAS

Map No. \_\_\_\_\_ Sec. 18 Twp. 11 R. 16W

Well No. 5 Romine

Republic Nat'l. Gas Company

Contractor \_\_\_\_\_

COMPLETED

SE NW NW

990 Ft. from N. Line

\_\_\_\_\_ Ft. from S. Line

\_\_\_\_\_ Ft. from E. Line

990 Ft. from W. Line

SECTION PLAT

0			

Location \_\_\_\_\_

Rig up \_\_\_\_\_

Drilling and Remarks:

*1000 Acid*

*POT- 2690*

RECORD (Corrected)

Cased 7 in. 3299 ft.

Sand 511 3298

Gas \_\_\_\_\_

Oil \_\_\_\_\_

Total Depth 3303

PRODUCTION

1st 24 hrs. Nat. \_\_\_\_\_

1st 24 hrs. after shot \_\_\_\_\_

Gas \_\_\_\_\_ Cu. Ft.

Dry Hole \_\_\_\_\_

Abandoned \_\_\_\_\_

Date

NOV 10 1937 19

H. D. Hatfield Scout