

KANSAS


FORM 51 5M 10-41 PETROL

Ellis

Section 18 Township 11 Range 16-W

Well No. #1 Thurston

Company Gulf Oil

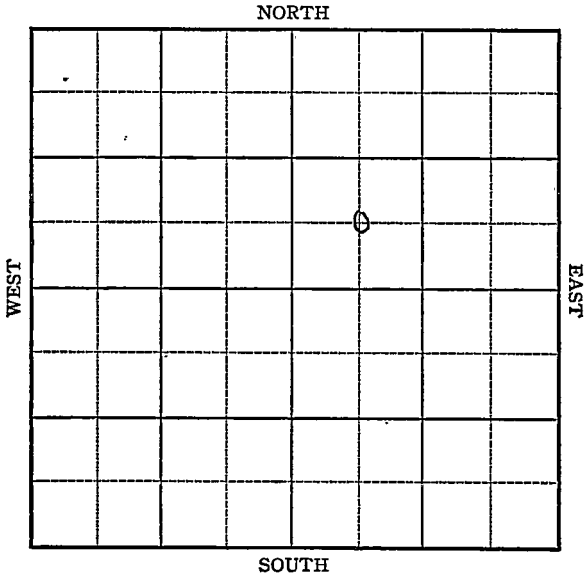

Sec. 18 Twp. 11 R. 16-W

Well No. #1 Thurston Farm

Gulf Company

Bemis


_____ Ft. from N. Line

660 Ft. from S. Line

_____ Ft. from E. Line

660 Ft. from W. Line

C SW NE *El. 1778*

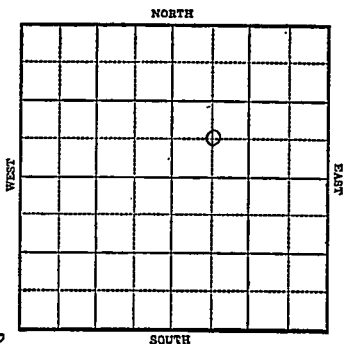

1943

R E P O R T

- 2/17 Location.
- 2/24 13" Casing set 88 WOC.
- 3/3 Drlg. 1783'
- 3/10 Drlg. 2825'
- 3/16 Lans 3006
Congl 3258
Viola 3267
Simp 3292
Arb 3328
TD 3334 show dead oil SD.
- 3/24 Lans 3006
Arb. 3328
T.D. 3334'
No shows.

ABANDONED

KANSAS
Map No. 71 Sec. 18 Twp. 11 R. 16W

Well No. 1 Thurston

Gulf Company

FIRST REPORT Contractor

C SW NE

SECTION PLAT

 Ft. from N. Line

660 Ft. from S. Line

 Ft. from E. Line

660 Ft. from W. Line

		o	

BEMIS POOL

Location XXXXX

Rig up

Drilling and Remarks:

RECORD

Cased in., ft.

Sand

Gas

Oil

Total Depth

PRODUCTION

1st 24 hrs. Nat.

1st 24 hrs. after shot

Gas Cu. Ft.

Dry Hole

Abandoned

Date

FEB 17 1943 19

S. J. LEWIS Scout

KANSAS
 Map No. 77 Sec. 18 Twp. 11 R. 16W

Well No. 1 Thurston

Gulf Company

ABANDONED Contractor

C SW NE

Ft. from N. Line

660 Ft. from S. Line

Ft. from E. Line

660 Ft. from W. Line

SECTION PLAT

		o	

BEMIS POOL

Location _____

Rig up _____

Drilling and Remarks:

Lane 8006

Cr 83328

No show

RECORD

Cased _____ in., _____ ft.

Sand _____

Gas _____

Oil _____

Total Depth 3334

PRODUCTION

1st 24 hrs. Nat. _____

1st 24 hrs. after shot _____

Gas _____ Cu. Ft.

Dry Hole _____

Abandoned _____

Date

MAR 24 1943 19

S. J. LEWIS Scout