


Section 18 Township 11 Range 16-W

Well No. 2 - Romine

Company Lario

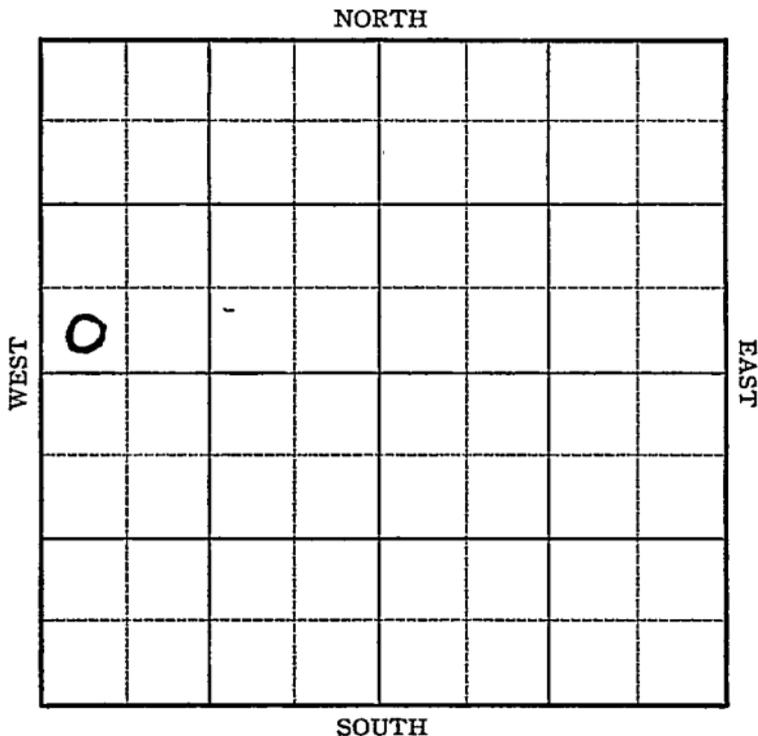

Sec. 18 Twp. 11 R. 16-W

Well No. #2 Romine Farm  
Lario Company


         Ft. from N. Line

330 Ft. from S. Line

         Ft. from E. Line

330 Ft. from W. Line

Elev. 1799

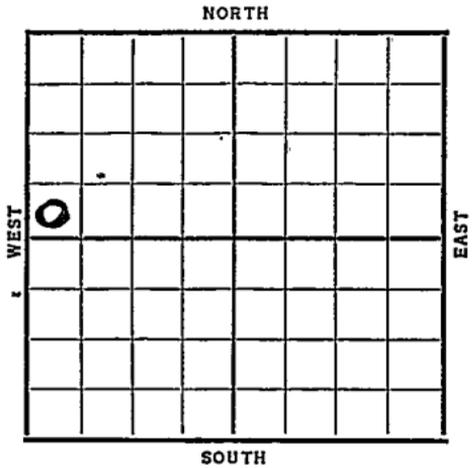

Date	REPORT
1937	
8/4	Location
8/13	"
8/20	R. R.
8/28	"
9/3	R U R
9/10	Anhy 986'. 10" @ 1006'. WOC.
9/17	TD 2200' SD repairs.
9/24	Drlg. 2830'.
10/2	Sil. & 6" @ 3306'. No shows. WOC.
10/8	T.D. 3310'. 3000' oil.
	<b>OVER</b>

1937

10/13 6" @ 3306' .

Sil. 3306' .

T.D. 3310' .

Pot. 2448 bbls. Nat.

COMPLETED

Map No. \_\_\_\_\_ Sec. 18 Twp. 11 R. 16 WWell No. 2 - RosineLario Company

Contractor

## FIRST REPORT

## SECTION PLAT

\_\_\_\_\_ Ft. from N. Line

330 Ft. from S. Line

\_\_\_\_\_ Ft. from E. Line

330 Ft. from W. Line

0			

Location 

Rig up \_\_\_\_\_

Drilling and Remarks:

## RECORD

Cased \_\_\_\_\_ in., \_\_\_\_\_ ft.

Sand \_\_\_\_\_

Gas \_\_\_\_\_

Oil \_\_\_\_\_

Total Depth \_\_\_\_\_

## PRODUCTION

1st 24 hrs. Nat. \_\_\_\_\_

1st 24 hrs. after shot. \_\_\_\_\_

Gas \_\_\_\_\_ Cu. Ft.

Dry Hole \_\_\_\_\_

Abandoned \_\_\_\_\_

Date

AUG 4 - 1937H. D. Hatfield Scout

Ellis **KANSAS**

Map No. \_\_\_\_\_ Sec. 18 Twp. 11 R. 16W

Well No. 2 Romine

Lario \_\_\_\_\_ Company

\_\_\_\_\_ Contractor

**COMPLETED**

SW NW

\_\_\_\_\_ Ft. from N. Line

330 Ft. from S. Line

\_\_\_\_\_ Ft. from E. Line

330 Ft. from W. Line

**SECTION PLAT**

0			

Location \_\_\_\_\_

Rig up \_\_\_\_\_

Drilling and Remarks:

**RECORD**

Cased 6 in., 3306 ft.

Sand 511-3306

Gas \_\_\_\_\_

Oil \_\_\_\_\_

Total Depth 3310

**PRODUCTION**

1st 24 hrs. Nat. \_\_\_\_\_

1st 24 hrs. after shot \_\_\_\_\_

Gas \_\_\_\_\_ Cu. Ft.

Dry Hole \_\_\_\_\_

Abandoned \_\_\_\_\_

*POT-2448*

*NAT*

Date

OCT 13 1937 19

H. D. Hatfield

Scout