


Ellis

Section.....18.....Township.....11.....Range.....16-W

Well Number.....2 - Romine.....

Company.....Republic Nat. Gas.....

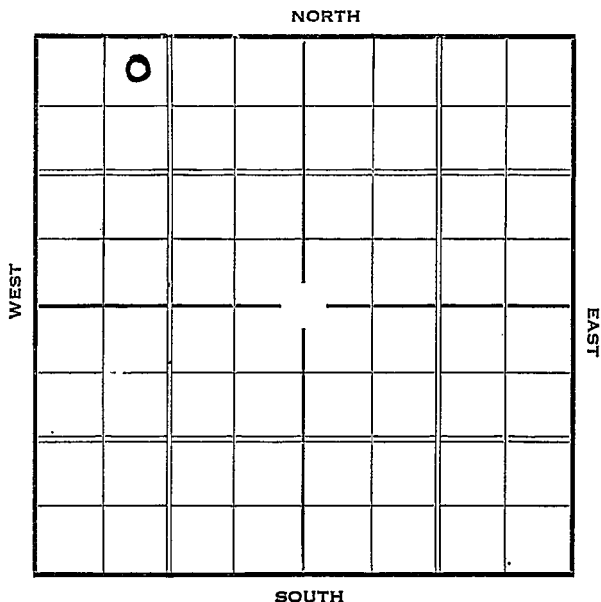

Sec. 18 Twp. 11 R. 16-W

Well No. #2 Romine Farm

Republic Nat. Gas Company


330 Ft. from N. Line

_____ Ft. from S. Line

_____ Ft. from E. Line

990 Ft. from W. Line

Elev. 1783

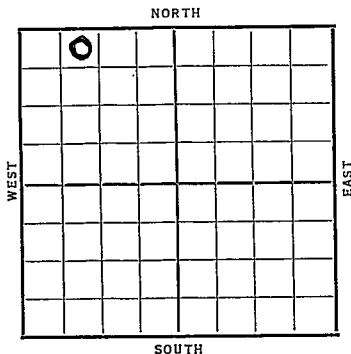

Date	REPORT
1937	
5/12	Mov. in Mat.
5/21	R.R.
5/28	"
6/4	"
6/11	"
6/19	"
6/25	"
7/2	S. H.
7/9	"
7/16	15" @ 101'. Anhy 970'.
	10" @ 980'. Drlg. 2270'.
7/23	Drlg. 3110'.
7/30	Sil. 3298'. 6" @ 3299'.
	RUST.
8/4	6" @ 3299'
	Sil 3298'
	TD 3303'
	Pot. 2927
	Mat.

COMPLETED

Ellis KANSAS

Map No. 71 Sec. 18 Twp. 11 R. 16^w

Well No. 2 - Romine

Republic Nat. Gas Company
Contractor

FIRST REPORT

330 Ft. from N. Line
 _____ Ft. from S. Line
 _____ Ft. from E. Line
990 Ft. from W. Line

SECTION PLAT

0			

Location _____

Rig up _____

Drilling and Remarks:

mov. in mat.

RECORD

Cased _____ in., _____ ft.

Sand _____

Gas _____

Oil _____

Total Depth _____

PRODUCTION

1st 24 hrs. Nat. _____

1st 24 hrs. after shot _____

Gas _____ Cu. Ft.

Dry Hole _____

Abandoned _____

Date

MAY 12 1931 19

H. D. Hatfield Scout

Ellis KANSASMap No. _____ Sec. 18 Twp. 11 R. 16 ^WWell No. 2-RomineRepublic Nat. Gas Company

Contractor

COMPLETED

330 Ft. from N. Line

_____ Ft. from S. Line

_____ Ft. from E. Line

990 Ft. from W. Line

SECTION PLAT

0			

Location _____

Rig up _____

Drilling and Remarks:

Lot - 2927nat

RECORD

Cased 6 in., 3299 ft.~~Sand~~ Si 3298

Gas _____

Oil _____

Total Depth 3303

PRODUCTION

1st 24 hrs. Nat. _____

1st 24 hrs. after shot _____

Gas _____ Cu. Ft.

Dry Hole _____

Abandoned _____

Date

AUG 4 - 1937 19H. D. Hatfield Scout