


Section 18 Township 11 Range 16<sup>W</sup>

Well No. #2 Thurston

Company Olive Moorshead  
Bemis

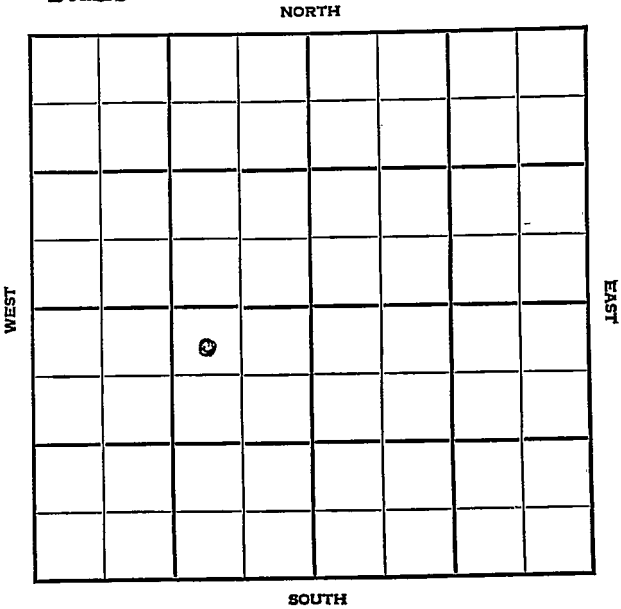

Sec. 18 Twp. 11 R. 16W

Well No. #2 Thurston Farm

Oliver Moorshead Company

Bemis

330 Ft. from N. Line


\_\_\_\_\_ Ft. from S. Line

990 Ft. from E. Line

\_\_\_\_\_ Ft. from W. Line

Twin well

NW NE SW

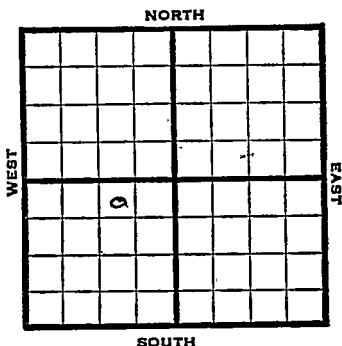

1947

Elev. 1811' REPORT

12/3

8" @ 1010'  
Anhy. 1005'  
Lans. 2993'  
B. KC 3240'  
Cong. 3276'  
Simp. 3292'  
Arb. 3322'  
SW 3344-54'  
TD 3383'  
Run 5"

12/10

TD 3385'  
5" @ 3385'  
RUST

12/17

"

12/30

10 shots 3321-22' - 1500 acid swb.  
4 bbls. oil  $\frac{1}{q}$  12 W PH 12 hrs.

1948

1/7

"

1/14

1000 acid  
swb 30 bbl s oil 3 hrs

1/21

"

~~2/26~~

"

2/4

"

2/11

"

OVER

1948

2/18 1000 acid  
Swb 30 bbls of 3 hrs.

2/25 "

3/3 "

3/10 "

3/17 Arb. 3322'  
5" @ 3385'  
Perf. 2000 Acid  
Pump 100 Pot.  
Gravity 36°  
TD 3385'  
**COMPLETED**

Map No. \_\_\_\_\_ Sec. 18 Twp. 11 R. 16W

Well No. 2 Thurston

Oliver Moorshead Company

FIRST REPORT Contractor

NW NE SW

SECTION PLAT

330 Ft. from N. Line

\_\_\_\_\_ Ft. from S. Line

990 Ft. from E. Line

\_\_\_\_\_ Ft. from W. Line


Ellis County

Location \_\_\_\_\_

Rig up \_\_\_\_\_

Drilling and Remarks:

twin well

8" @ 1010

Anhy 1005

Lans. 2993

B KC 3240

Cong. 3276

Simp. 3292

Arb. 3322

Date SW 3344-54

Run 5"

DEC 3 1947

19

TD 3383

RECORD

Cased \_\_\_\_\_ in., \_\_\_\_\_ ft.

Sand \_\_\_\_\_

Gas \_\_\_\_\_

Oil \_\_\_\_\_

Total Depth \_\_\_\_\_

PRODUCTION

1st 24 hrs. Nat. \_\_\_\_\_

1st 24 hrs. after shot \_\_\_\_\_

Gas \_\_\_\_\_ Cu. Ft.

Dry Hole \_\_\_\_\_

Abandoned \_\_\_\_\_

S. J. LEWIS Scout

Map No. 71 Sec. 18 Twp. 11 R. 16W

Well No. 2 Thurston

Oliver Moorshead Company

**COMPLETE** Contractor

NW NE SW

*E. 15 1/2*  
SECTION PLAT

• 330 Ft. from N. Line

         Ft. from S. Line

990 Ft. from E. Line

         Ft. from W. Line

	o		

Ellis County

RECORD

Location                                 

Cased          in.,          ft.

Rig up                                 

Sand                                 

Drilling and Remarks:

Gas                                 

*CR 8322*

*5" @ 3385-*

Oil   ✓  

Total Depth   3385  

*Prof. 2000 acid*

*Permu 100 Pst*

PRODUCTION

1st 24 hrs. Nat.                         

1st 24 hrs. after shot                         

Gas                          Cu. Ft.

Dry Hole                         

Abandoned                         

*360 3/4*

Date

MAR 17 1948

S. J. LEWIS Scout