


Section 18 Township 11 Range 16-W

Well No. 3 - Romine

Company Republic Nat.Gas.

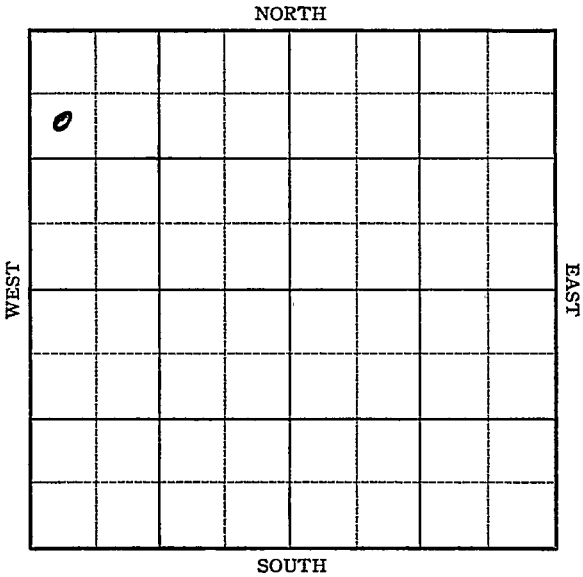


KANSAS

Ellis

Sec. 18 Twp. 11 R. 16-WWell No. #3 Romine FarmRepublic Nat Gas. Company990 Ft. from N. Line Ft. from S. Line Ft. from E. Line330 Ft. from W. Line

Elev. 1771

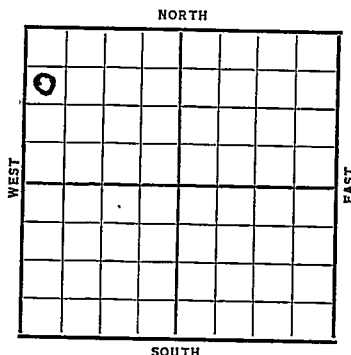

Date

REPORT

1937

6/16 Cellar

6/25 "

7/2 Rig.

7/9 "

7/16 "

7/23 "

7/30 15" @ 100'. WOC.

8/6 Anhy 958'. 10" @ 972'. WOC.

8/13 Drlg. 2330'.

8/20 S.O. 3014'. Drlg. 3128'.

8/28 Sil. & 7" @ 3281'.

T.D. 3282'. RUST.

OVER

1937

9/1

7" @ 3281'.

Sil. 3281'.

T.D. 3287'.

Pump 481 bbls. 4 hrs.

485 bbls. 4 hrs.

Pot. 2889 bbls. Nat.

COMPLETED

KANSAS

Map No. 71 Sec. 18 Twp. 11 R. 16 ^WWell No. 3 - Romine
Republic Nat Gas Company

Contractor

FIRST REPORT

SECTION PLAT

990 Ft. from N. Line

_____ Ft. from S. Line

_____ Ft. from E. Line

330 Ft. from W. Line

0			

Location _____

Rig up _____

Drilling and Remarks:

Cellar

RECORD

Cased _____ in., _____ ft.

Sand _____

Gas _____

Oil _____

Total Depth: _____

PRODUCTION

1st 24 hrs. Nat. _____

1st 24 hrs. after shot _____

Gas _____ Cu. Ft.

Dry Hole _____

Abandoned _____

Date

JUN 16 1937 19

H. D. Hatfield

Scout

Ellis KANSAS

Map No. _____ Sec. 18 Twp. 11 R. 16WWell No. 3 - Rosine
Republic Nat. Gas Company

Contractor _____

COMPLETED

SECTION PLAT

990 Ft. from N. Line

_____ Ft. from S. Line

_____ Ft. from E. Line

330 Ft. from W. Line

0			

Location _____

RECORD

Cased 7 in. 3281 ft.Sand 511 3281

Gas _____

Oil _____

Total Depth 3287

PRODUCTION

1st 24 hrs. Nat. _____

1st 24 hrs. after shot _____

Gas _____ Cu.-Ft.

Dry Hole _____

Abandoned _____

Drilling and Remarks:

P. - 481/4 & 485/4Pot - 2889

Nat

Date

SEP 1 1937 19

H. D. Hatfield Scout